
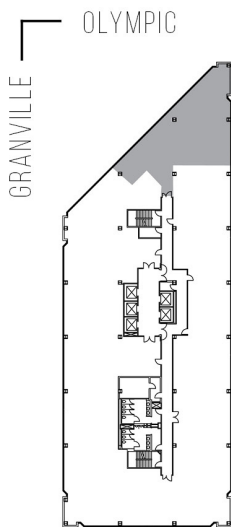


# 11845 OLYMPIC

WESTSIDE TOWERS WEST TOWER

SUITE 780 | 2,930 RSF

SAWTELLE/WEST LA

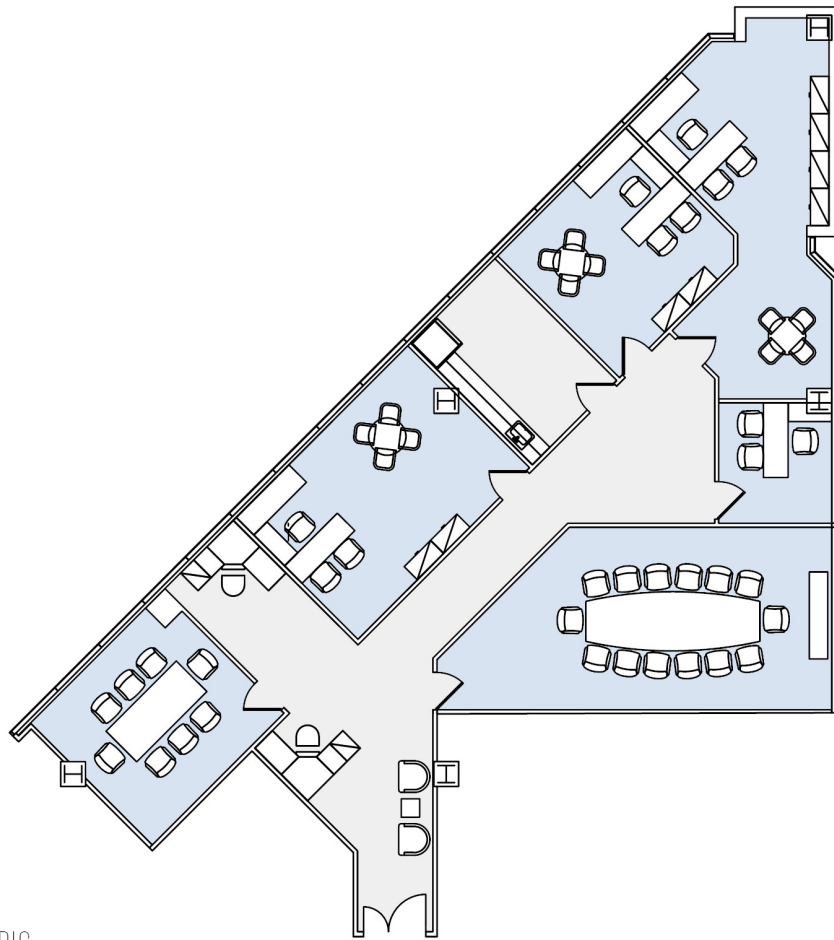

#### AS-BUILT CONFIGURATION

OFFICES:	4
CONFERENCE ROOMS:	2
RECEPTION:	1
KITCHEN:	1

NOT TO SCALE  
FURNITURE NOT INCLUDED

For more information, please contact:

310.255.7777  
leasing@douglasemmett.com

**Douglas  
Emmett**