


# 15821 VENTURA

ENCINO TERRACE

SUITE 460 | 3,767 RSF

SHERMAN OAKS/ENCINO

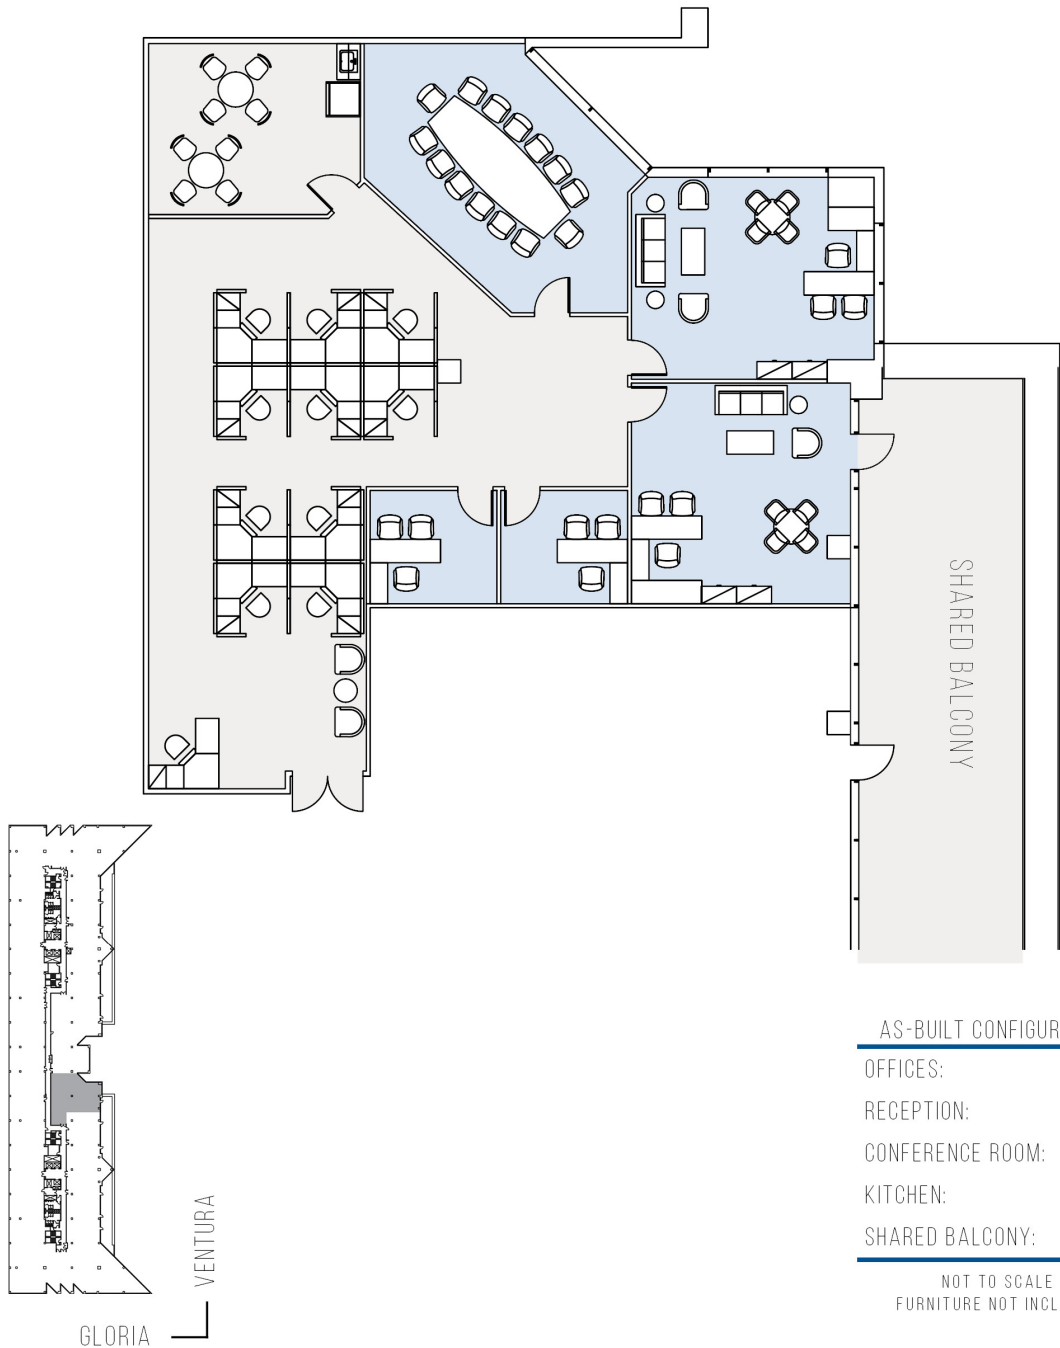

For more information, please contact:

310.255.7777  
leasing@douglasemmett.com

**Douglas  
Emmett**