



1990

CORNERSTONE PLAZA

SUITE 250 | 3,835 RSF

SAWTELLE/WEST LA

# SOUTH BUNDY

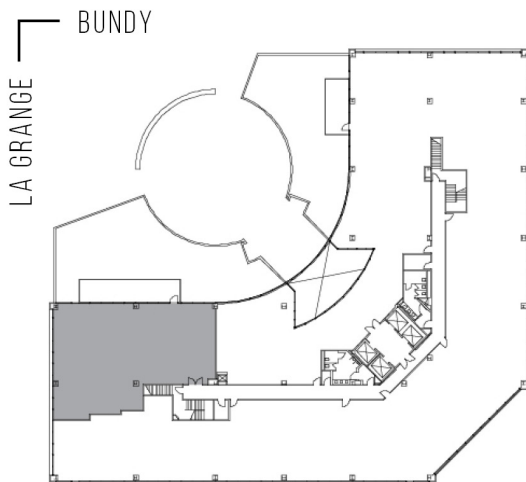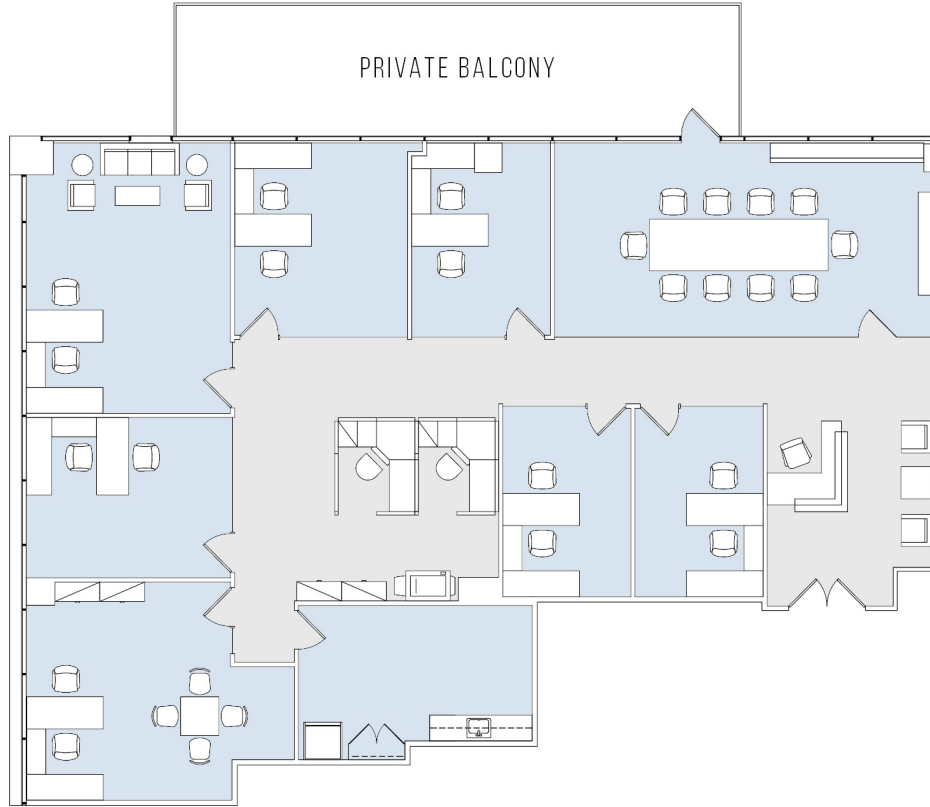

### AS-BUILT CONFIGURATION

OFFICES:	7
CONFERENCE ROOM:	1
RECEPTION:	1
KITCHEN:	1
I.T. CLOSET:	1
PRIVATE BALCONY:	1

ADJUSTED FOR SOCIAL DISTANCING  
NOT TO SCALE  
FURNITURE NOT INCLUDED

For more information, please contact:

310.255.7777  
leasing@douglasemmett.com

**Douglas  
Emmett**