



# 21650

WARNER CENTER TOWER - III

SUITE 1540 | 1,815 RSF

WOODLAND HILLS

## OXNARD STREET

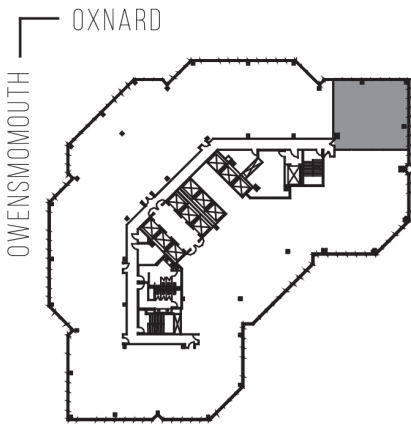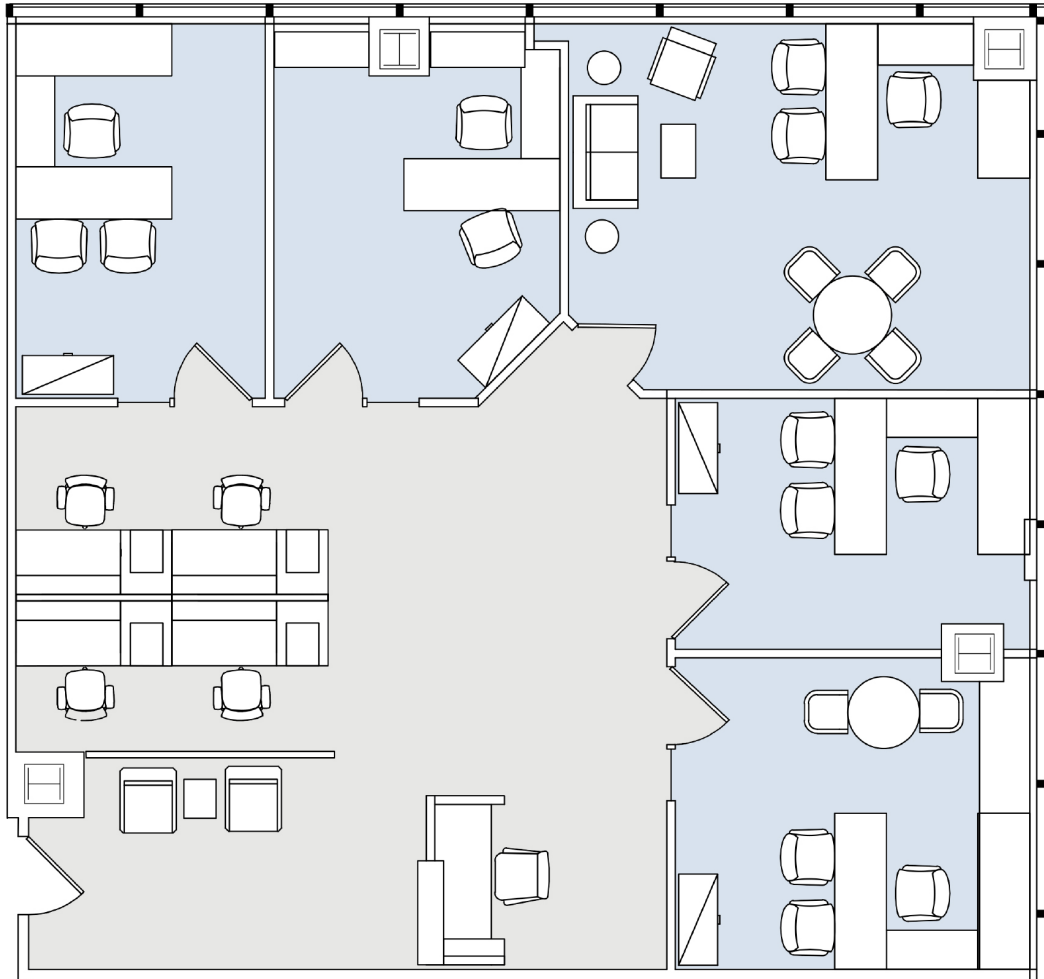

### AS-BUILT CONFIGURATION

OFFICES:	5
WORKSTATIONS:	4
RECEPTION:	1

NOT TO SCALE  
FURNITURE NOT INCLUDED

For more information, please contact:

310.255.7777

leasing@douglasemmett.com

**Douglas  
Emmett**