
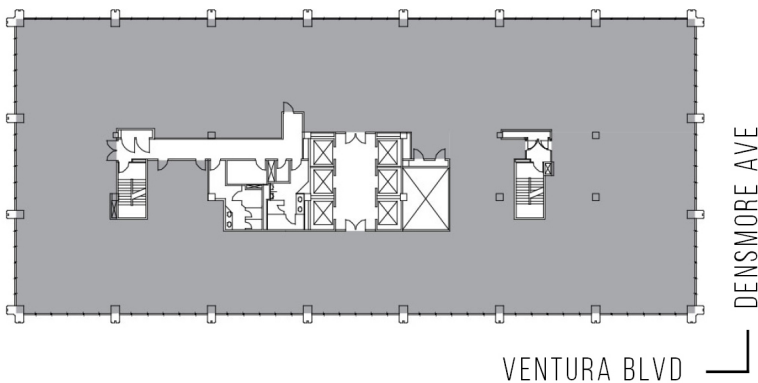


15760 VENTURA

ENCINO GATEWAY

SUITE 1600 | 18,325 RSF

SHERMAN OAKS/ENCINO

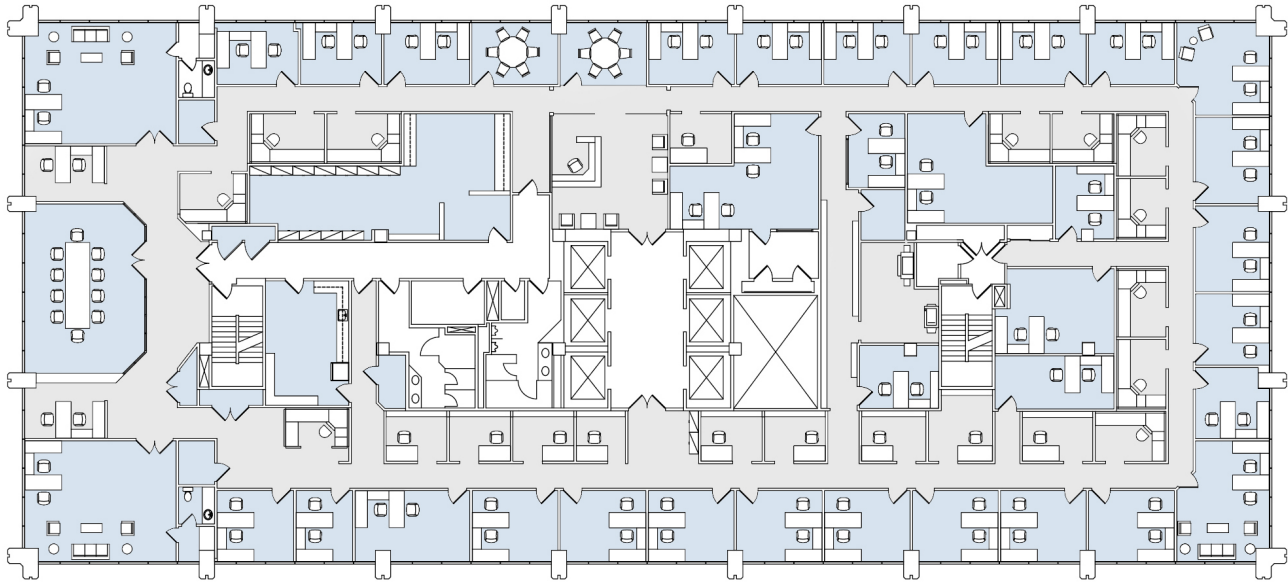

AS-BUILT CONFIGURATION

OFFICES:	35
CONFERENCE ROOMS:	3
RECEPTION:	1
KITCHEN:	1
FILE ROOM:	1
RESTROOMS:	1
PRIVATE RESTROOMS:	2
I.T. ROOM:	1
STORAGE ROOMS:	3
STORAGE CLOSETS:	3
COPY ROOM:	1
WORK STATIONS:	20

ADJUSTED FOR SOCIAL DISTANCING
NOT TO SCALE
FURNITURE NOT INCLUDED

For more information, please contact:

310.255.7777

leasing@douglasemmett.com

**Douglas
Emmett**