
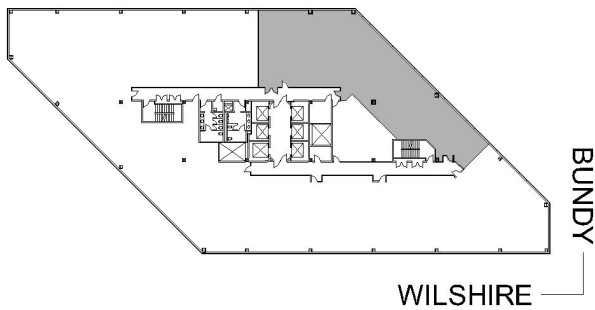


12121 WILSHIRE

WILSHIRE BUNDY PLAZA

SUITE 750 | 4,284 RSF

BRENTWOOD-WILSHIRE

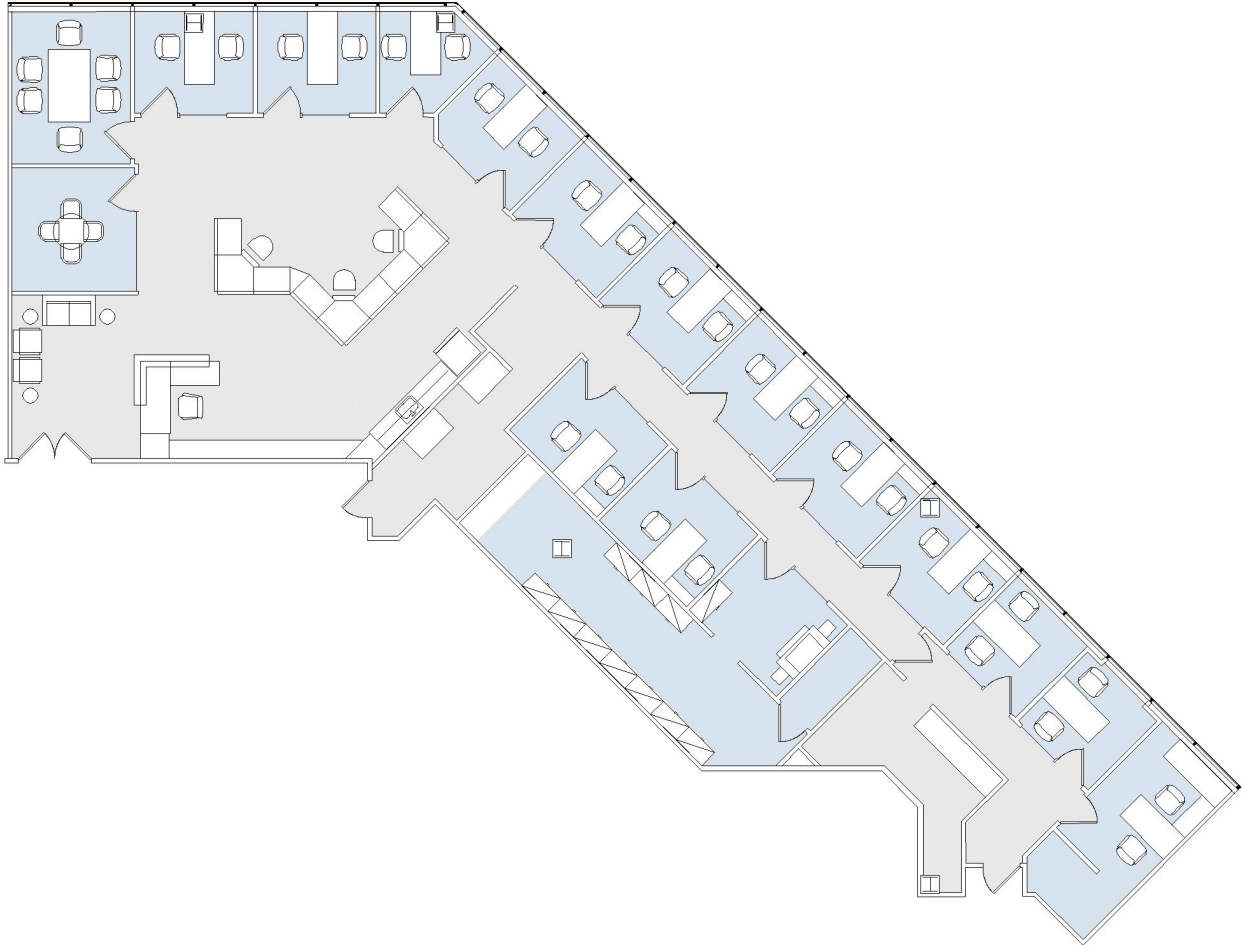

AS-BUILT CONFIGURATION

OFFICES:	14
CONFERENCE ROOM:	2
RECEPTION:	1
KITCHEN:	1
CLOSET:	1
SERVER ROOM:	1
FILE ROOM:	1

NOT TO SCALE

FURNITURE NOT INCLUDED

For more information, please contact:

310.255.7777

leasing@douglasemmett.com

**Douglas
Emmett**