


10960

WILSHIRE

SUITE 400 | 11,354 RSF

WESTWOOD

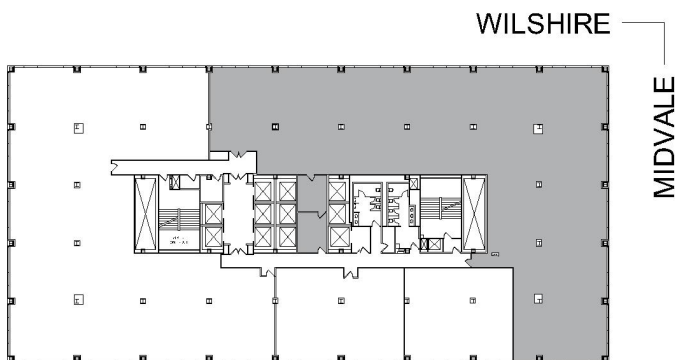

AS-BUILT CONFIGURATION

OFFICES:	12
CONFERENCE ROOM:	3
RECEPTION:	1
KITCHEN:	1
IT ROOM:	1
STORAGE ROOM:	1

NOT TO SCALE
FURNITURE NOT INCLUDED

For more information, please contact:

310.255.7777
leasing@douglasemmett.com

