



1001

BISHOP SQUARE - ASB TOWER

SUITE 112 | 1,395 RSF

HONOLULU

BISHOP STREET

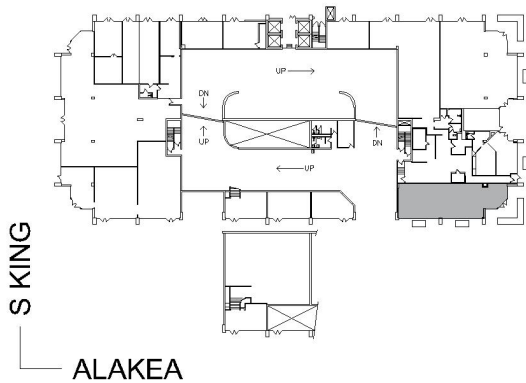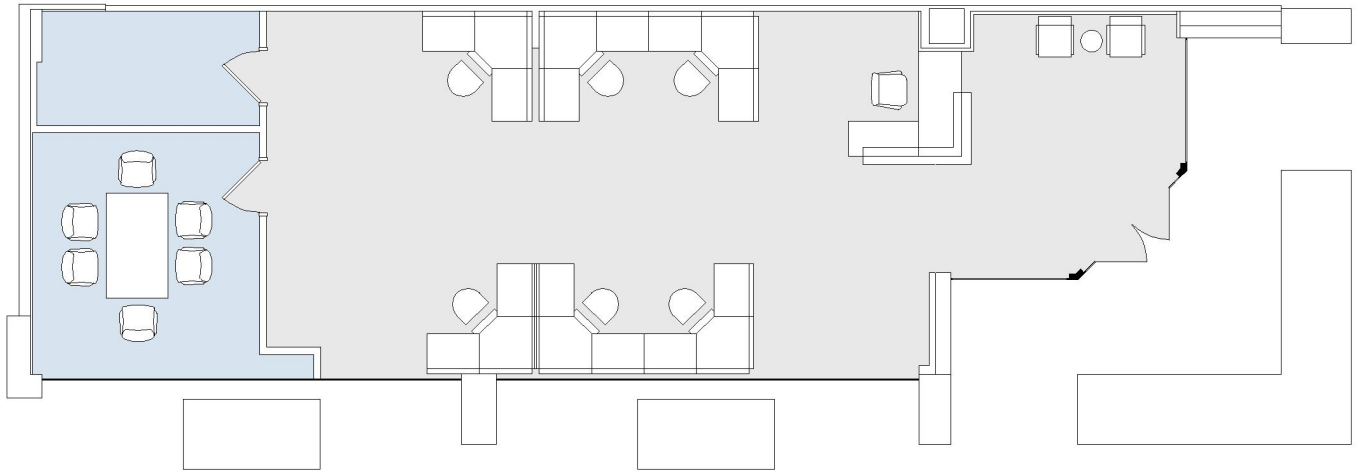

AS-BUILT CONFIGURATION

CONFERENCE ROOM:	1
RECEPTION:	1
STORAGE:	1

NOT TO SCALE
FURNITURE NOT INCLUDED

For more information, please contact:

310.255.7777
leasing@douglasemmett.com

**Douglas
Emmett**