



# 1001

BISHOP SQUARE - ASB TOWER

SUITE 112 | 1,395 RSF

HONOLULU

## BISHOP STREET

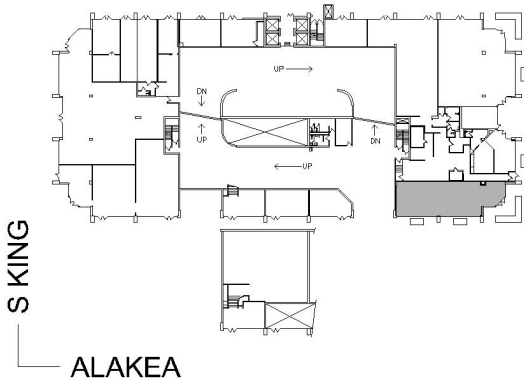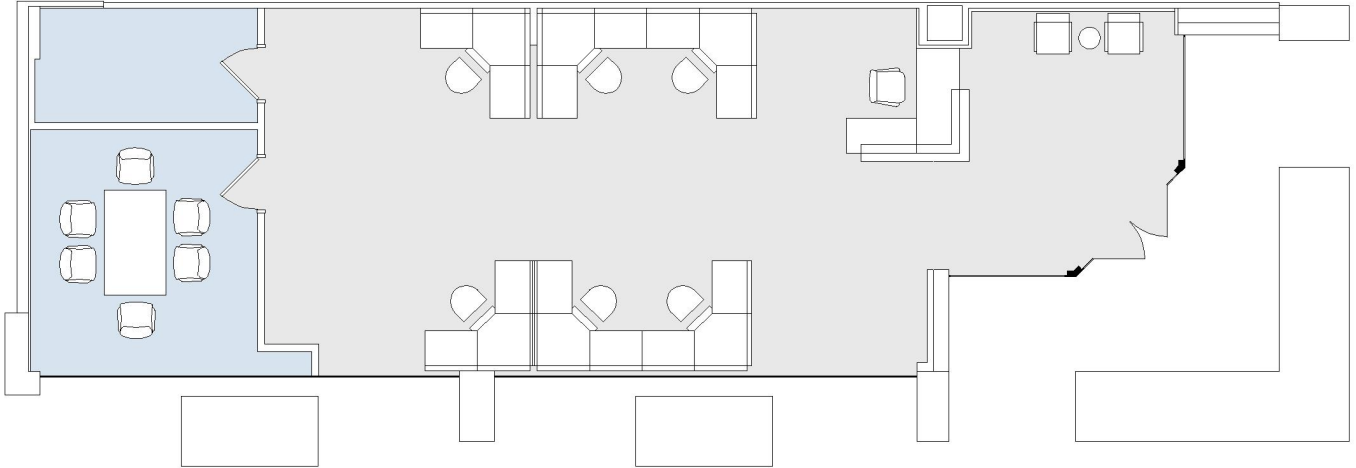

### AS-BUILT CONFIGURATION

CONFERENCE ROOM:	1
RECEPTION:	1
STORAGE:	1

NOT TO SCALE  
FURNITURE NOT INCLUDED

For more information, please contact:

310.255.7777

leasing@douglasemmett.com

**Douglas  
Emmett**