



1001

BISHOP SQUARE - ASB TOWER

SUITE 630 | 592 RSF

HONOLULU

BISHOP STREET

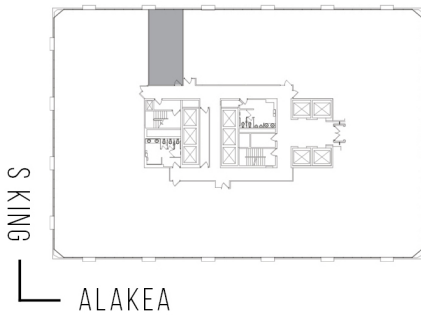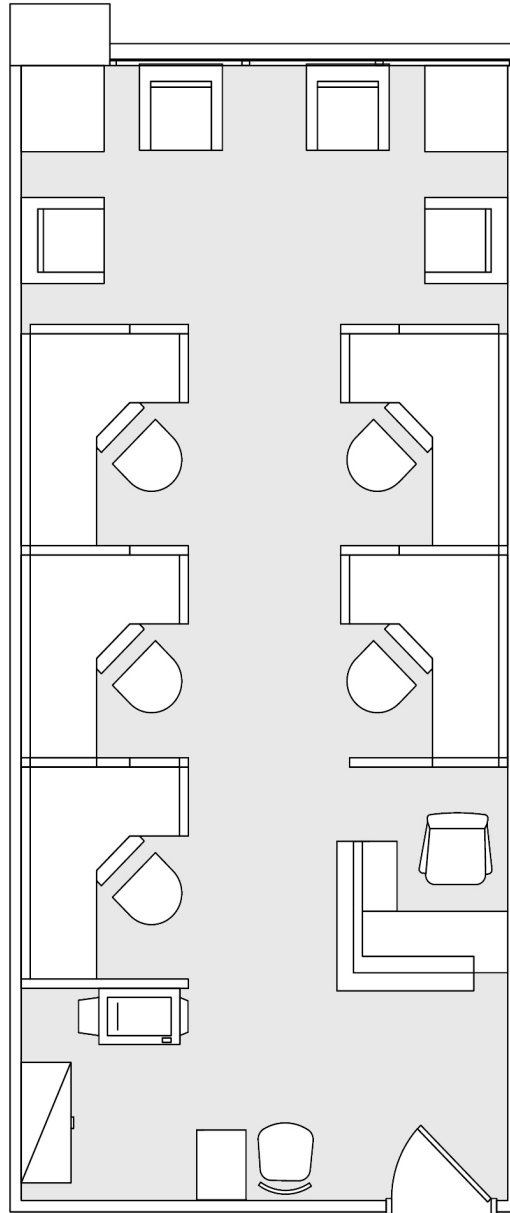

AS-BUILT CONFIGURATION
ADJUSTED FOR SOCIAL DISTANCING
NOT TO SCALE
FURNITURE NOT INCLUDED

For more information, please contact:

310.255.7777
leasing@douglasemmett.com

**Douglas
Emmett**