



12121

WILSHIRE BUNDY PLAZA

SUITE 1015 | 1,713 RSF

BRENTWOOD-WILSHIRE

# WILSHIRE

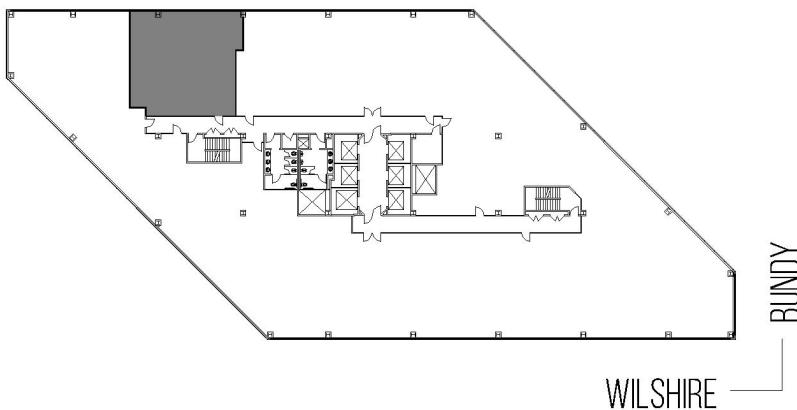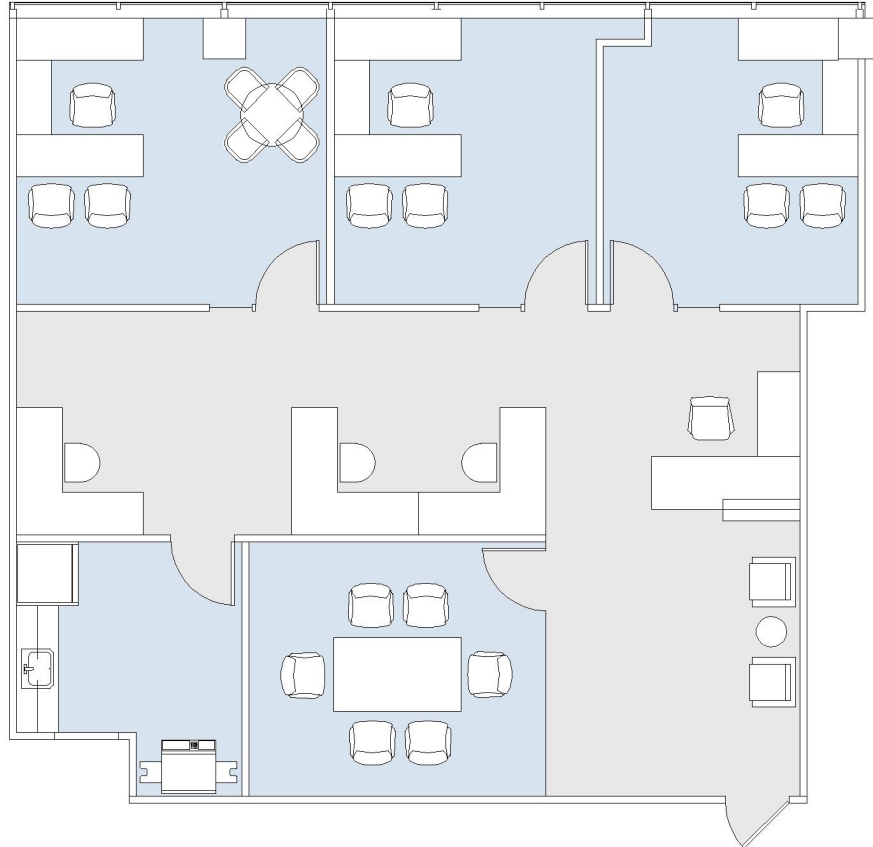

### AS-BUILT CONFIGURATION

OFFICES:	3
CONFERENCE ROOM:	1
RECEPTION:	1
KITCHEN:	1

NOT TO SCALE  
FURNITURE NOT INCLUDED

For more information, please contact:

310.255.7777  
leasing@douglasemmett.com

**Douglas  
Emmett**