
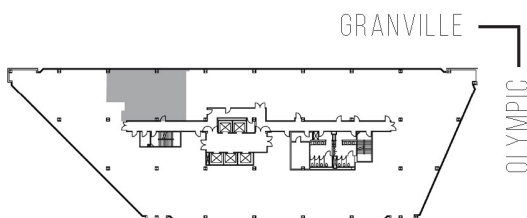


11835 OLYMPIC

WESTSIDE TOWERS EAST TOWER

SUITE 775 | 1,793 RSF

SAWTELLE/WEST LA

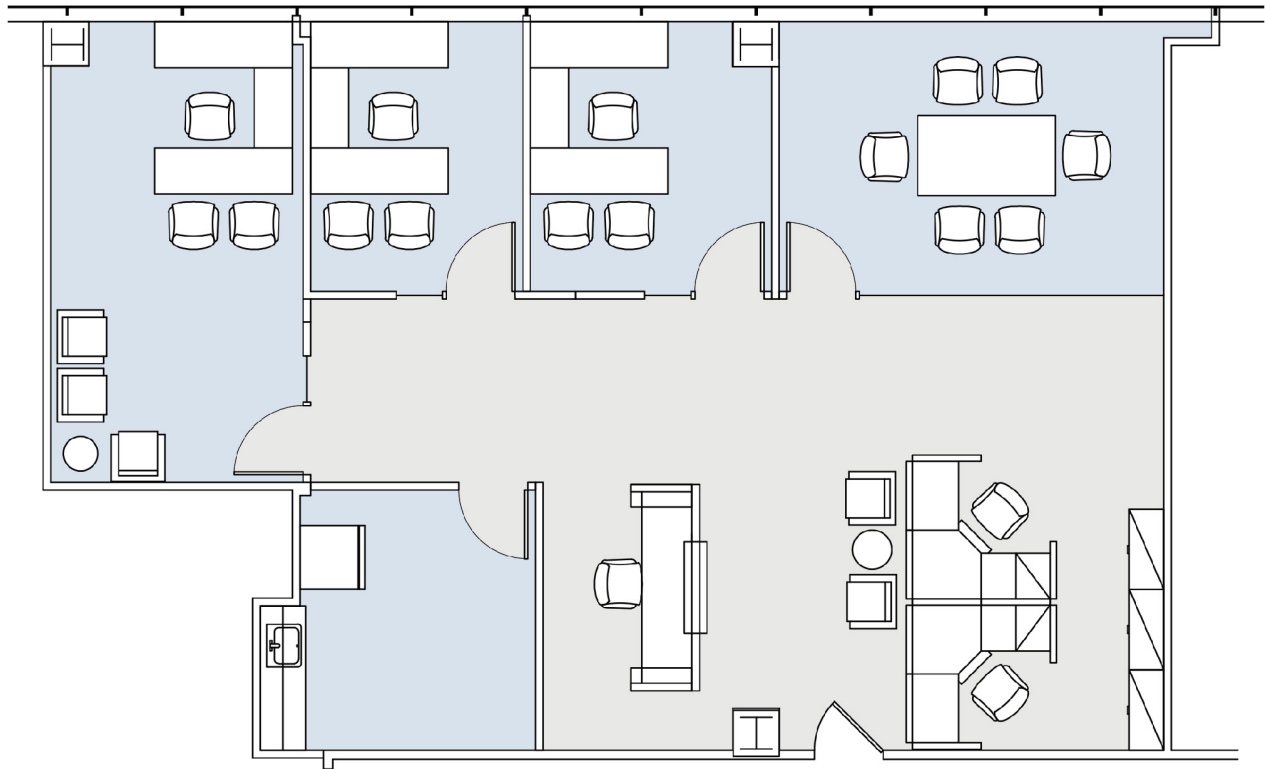

AS-BUILT CONFIGURATION

OFFICES:	3
CONFERENCE ROOM:	1
WORKSTATION:	2
KITCHEN:	1
RECEPTION:	1

NOT TO SCALE
FURNITURE NOT INCLUDED

For more information, please contact:

310.255.7777

leasing@douglasemmett.com

**Douglas
Emmett**