



55

HARBOR COURT - OFFICE

SUITE 1710 | 4,642 RSF

HONOLULU

MERCHANT STREET

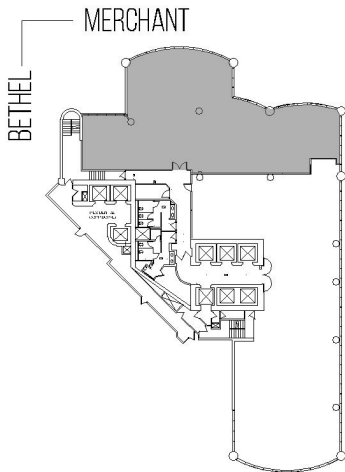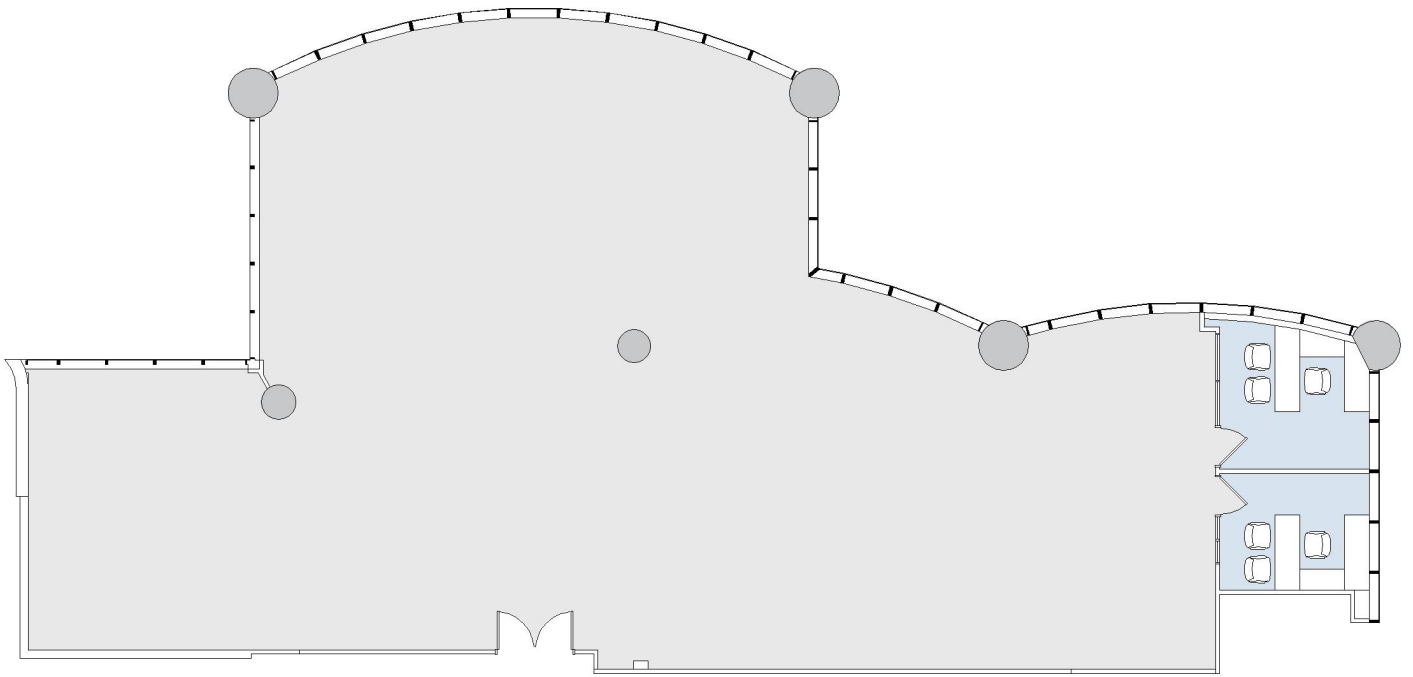

AS-BUILT CONFIGURATION

OFFICES: 2

ADJUSTED FOR SOCIAL DISTANCING
NOT TO SCALE
FURNITURE NOT INCLUDED

For more information, please contact:

310.255.7777

leasing@douglasemmett.com

**Douglas
Emmett**