
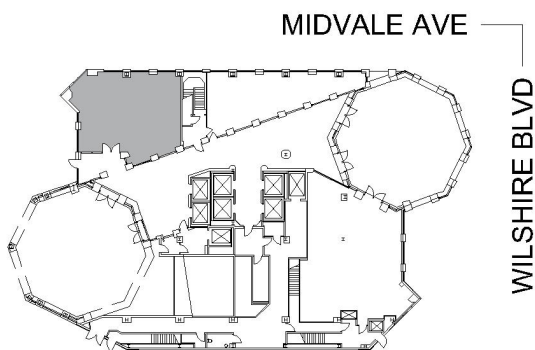


# 10940 WILSHIRE

THE TOWER

SUITE 110 | 1,626 RSF

WESTWOOD

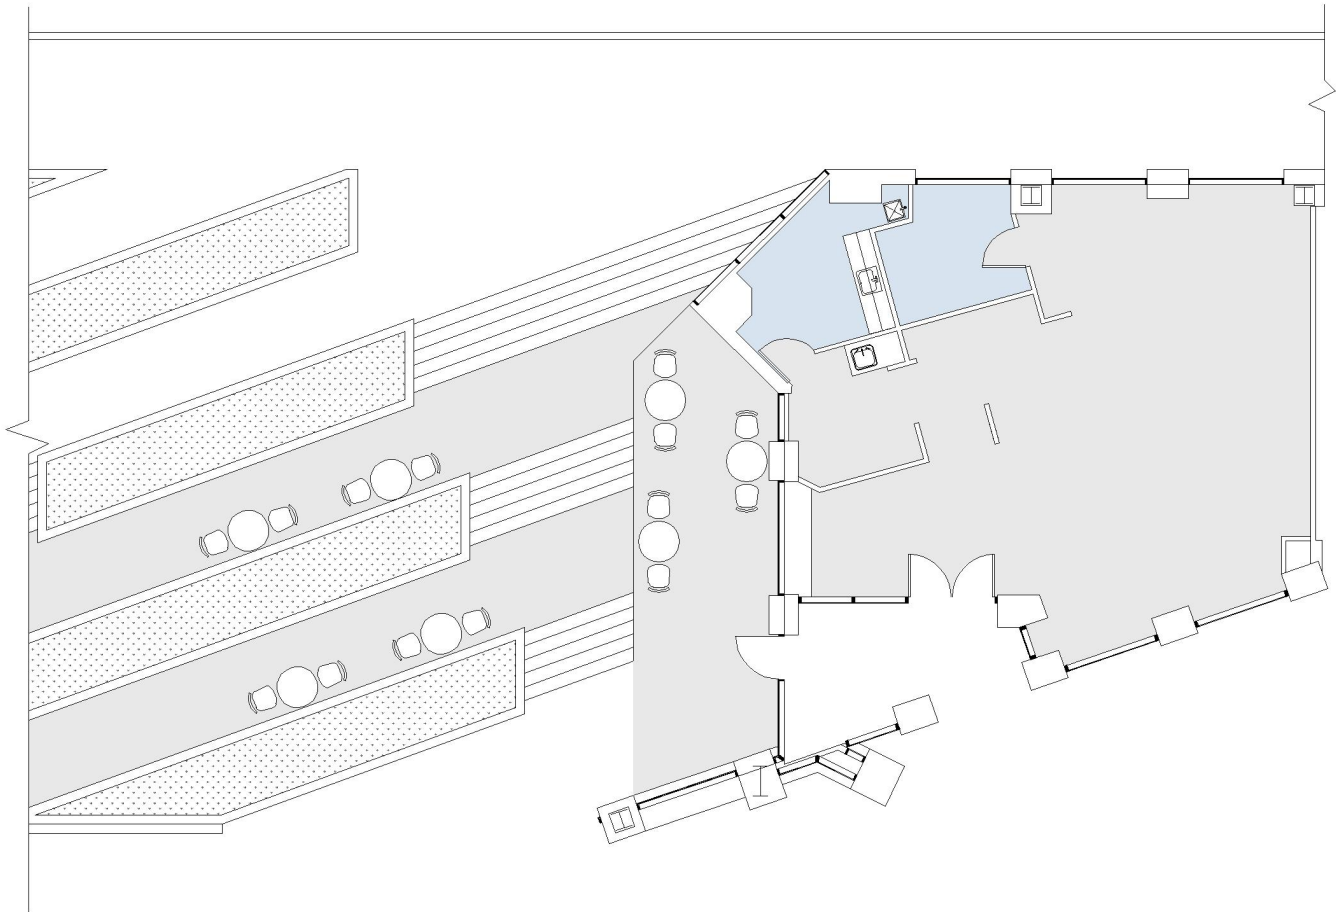

#### AS-BUILT CONFIGURATION

STORAGE:	1
KITCHEN:	1
SEATING AREA:	1
OUTDOOR SEATING AREA:	1

NOT TO SCALE

FURNITURE NOT INCLUDED

For more information, please contact:

310.255.7777

leasing@douglasemmett.com

**Douglas  
Emmett**