
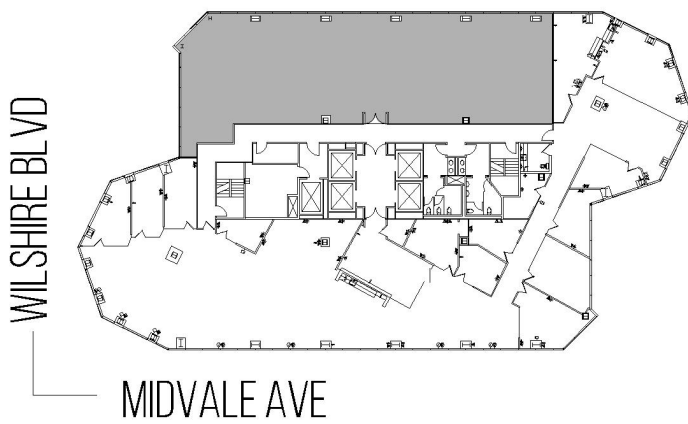


10940 WILSHIRE

THE TOWER

SUITE 1050 | 4,258 RSF

WESTWOOD

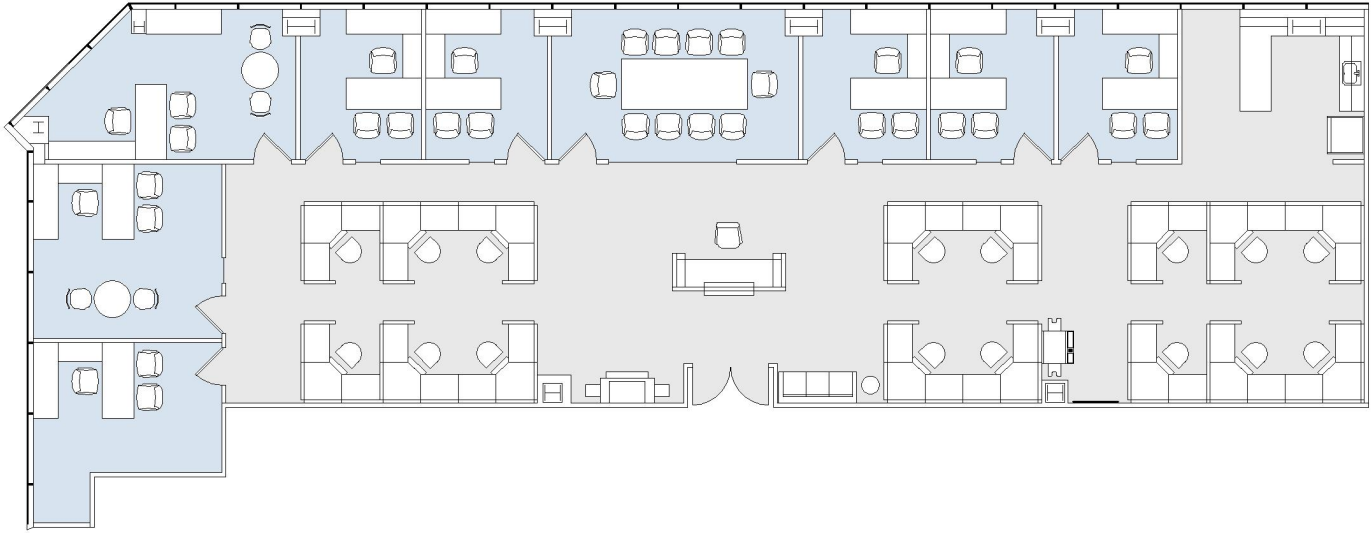

AS-BUILT CONFIGURATION

OFFICES:	8
CONFERENCE ROOM:	1
RECEPTION:	1
KITCHEN:	1

NOT TO SCALE
FURNITURE NOT INCLUDED

For more information, please contact:

310.255.7777
leasing@douglasemmett.com

**Douglas
Emmett**