


# 808 WILSHIRE

LINCOLN/WILSHIRE

SUITE 300 | 19,043 RSF

SANTA MONICA

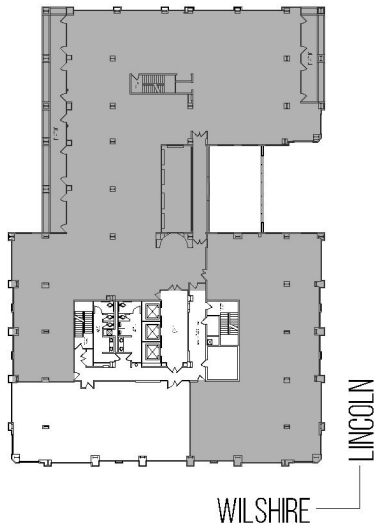

#### AS-BUILT CONFIGURATION

OFFICES:	27
CONFERENCE ROOM:	4
RECEPTION:	1
KITCHEN:	2
BREAK ROOM:	3
STORAGE ROOM:	2
IT ROOM:	1
PRIVATE PATIO:	2
SHARED OFFICE:	2

NOT TO SCALE  
FURNITURE NOT INCLUDED

For more information, please contact:

310.255.7777  
leasing@douglasemmett.com

**Douglas  
Emmett**