



1990

CORNERSTONE PLAZA

SUITE 620 | 3,904 RSF

SAWTELLE/WEST LA

SOUTH BUNDY

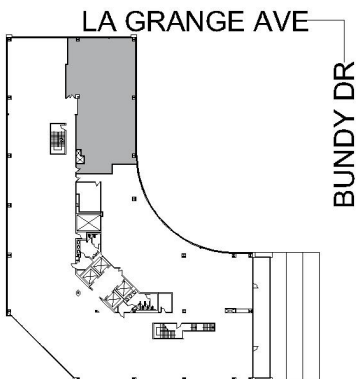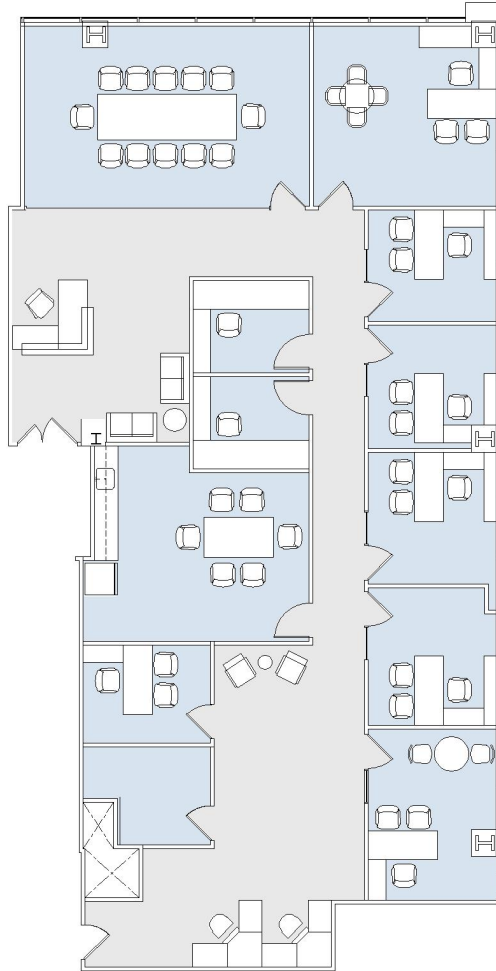

AS-BUILT CONFIGURATION

OFFICES:	9
CONFERENCE ROOM:	1
RECEPTION:	1
KITCHEN:	1
IT ROOM:	1

NOT TO SCALE
FURNITURE NOT INCLUDED

For more information, please contact:

310.255.7777
leasing@douglasemmett.com

**Douglas
Emmett**