



10866

WESTWOOD PLACE

SUITE 750 | 2,339 RSF

WESTWOOD

WILSHIRE

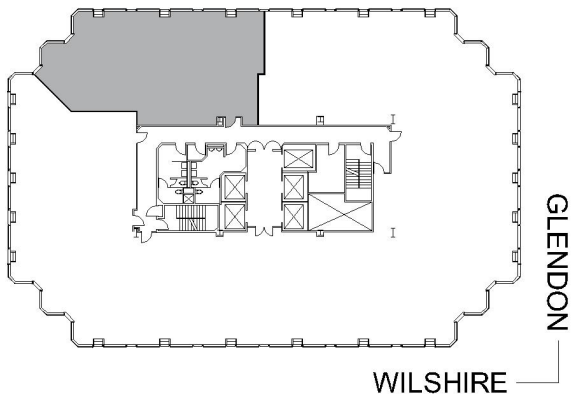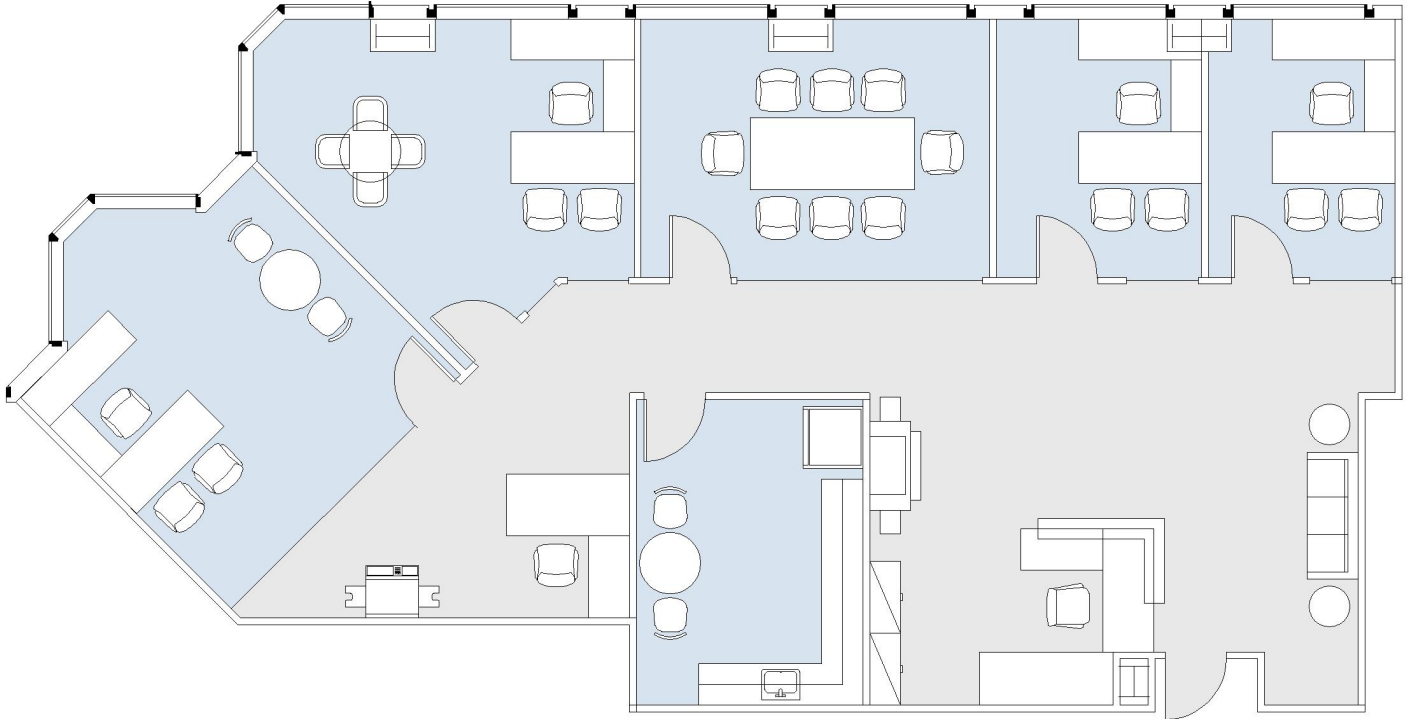

AS-BUILT CONFIGURATION

---

OFFICES:	4
CONFERENCE ROOM:	1
RECEPTION:	1
KITCHEN:	1

---

NOT TO SCALE

FURNITURE NOT INCLUDED

For more information, please contact:

310.255.7777  
leasing@douglasemmett.com

**Douglas  
Emmett**