
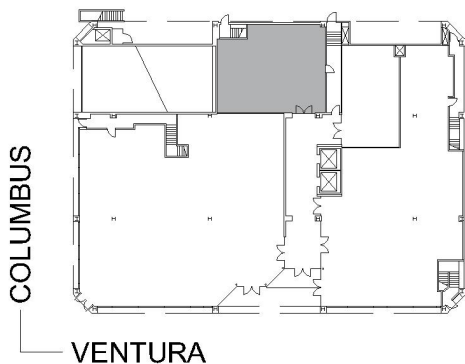


15165 VENTURA

COLUMBUS CENTER

SUITE 120 | 1,602 RSF

SHERMAN OAKS/ENCINO

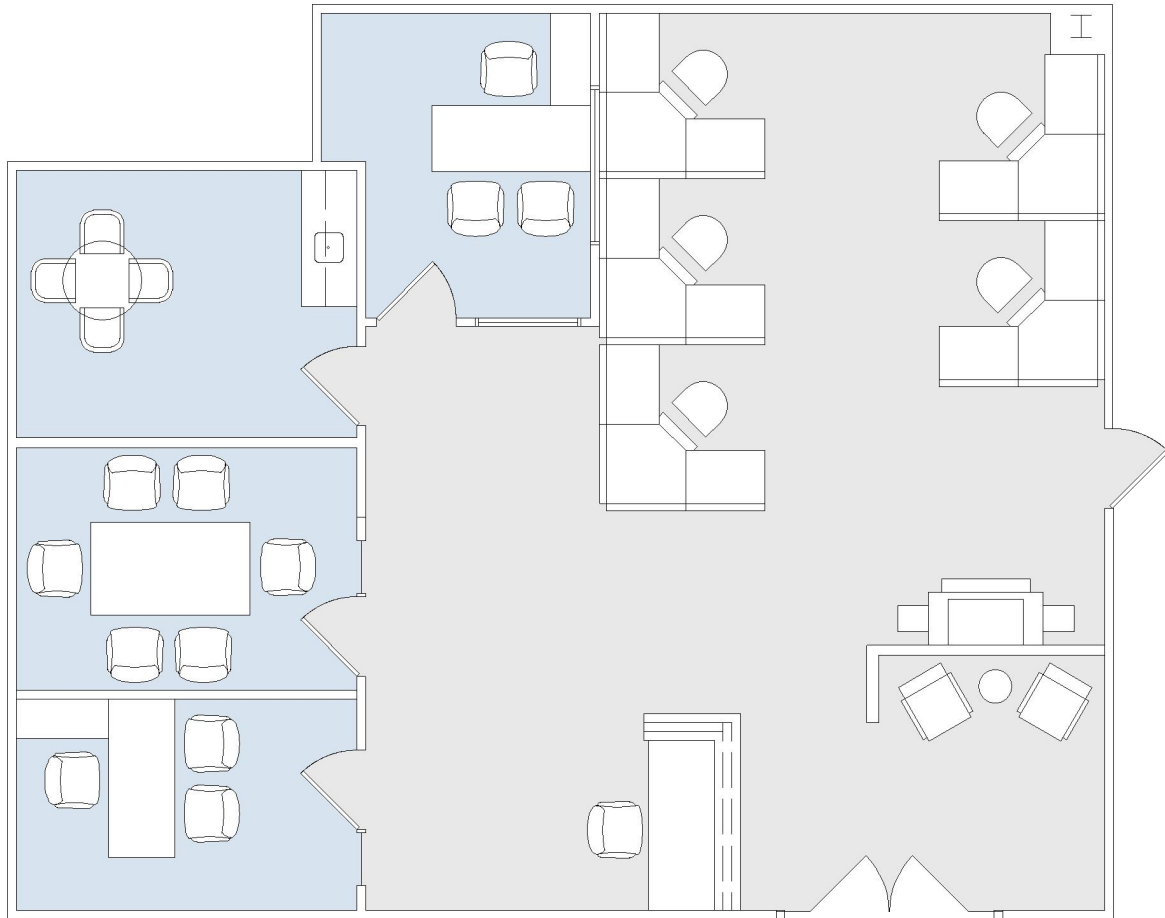

AS-BUILT CONFIGURATION

OFFICES:	2
CONFERENCE ROOM:	1
RECEPTION:	1
KITCHEN:	1

NOT TO SCALE

FURNITURE NOT INCLUDED

For more information, please contact:

310.255.7777

leasing@douglasemmett.com

**Douglas
Emmett**