
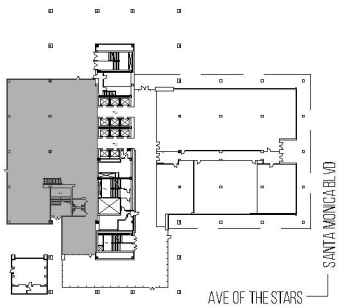
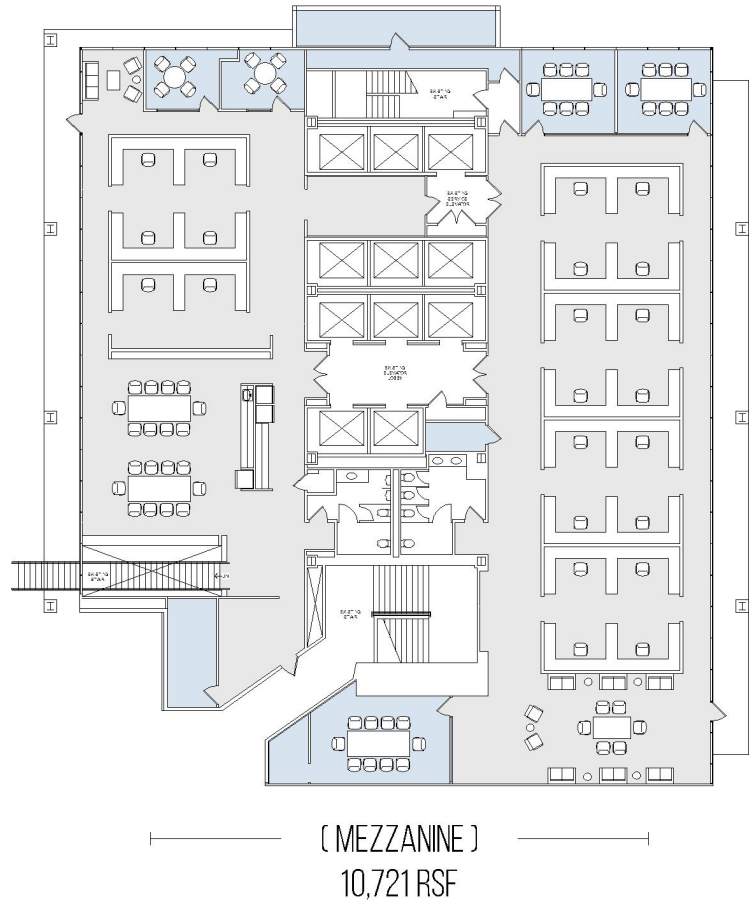


# 1901 AVENUE OF THE STARS


SUITE 175 | 21,943 RSF  
CENTURY CITY

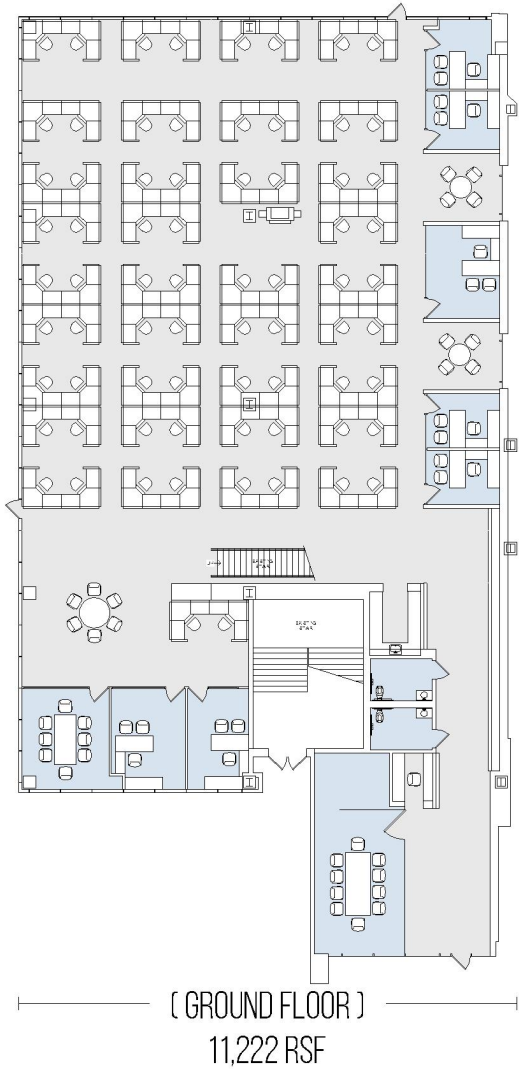

**AS-BUILT CONFIGURATION  
GROUND LEVEL**

OFFICES:	7
CONFERENCE ROOM:	2
RECEPTION:	1
KITCHENETTE:	1
PRIVATE RESTROOMS:	2
INTERNAL STAIRWELL	

NOT TO SCALE  
FURNITURE NOT INCLUDED

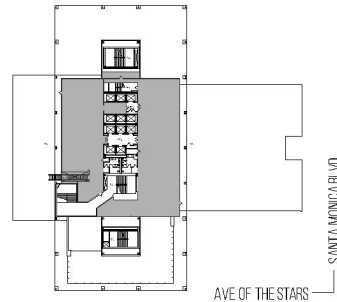

**AS-BUILT CONFIGURATION  
MEZZANINE**

BREAK ROOMS:	2
CONFERENCE ROOM:	3
RESTROOMS:	2
KITCHENETTE:	1
STORAGE ROOMS:	3
INTERNAL STAIRWELL	

NOT TO SCALE  
FURNITURE NOT INCLUDED

For more information, please contact:

310.255.7777  
leasing@douglasemmett.com

**Douglas  
Emmett**