


# 1901

SUITE 175 | 21,943 RSF


CENTURY CITY

## AVENUE OF THE STARS

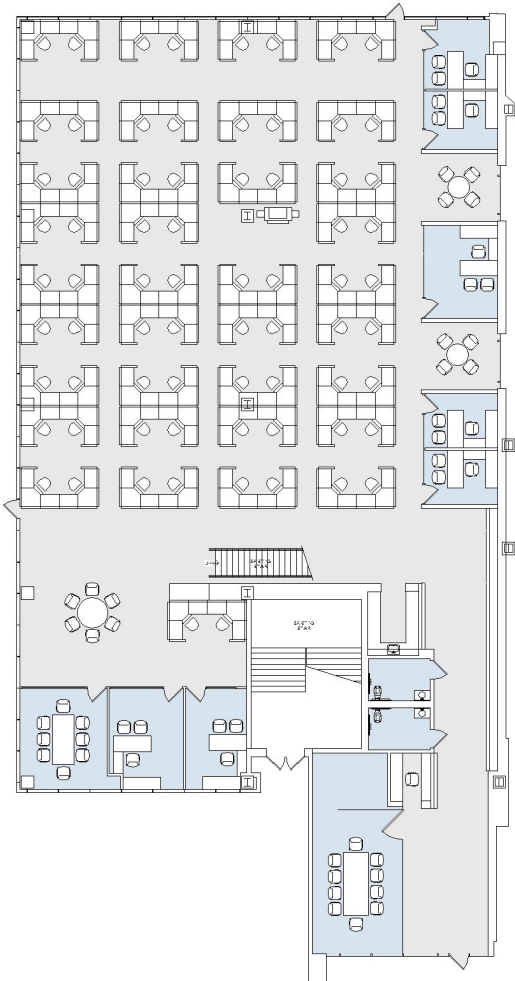


[ GROUND FLOOR ]

11,222 RSF

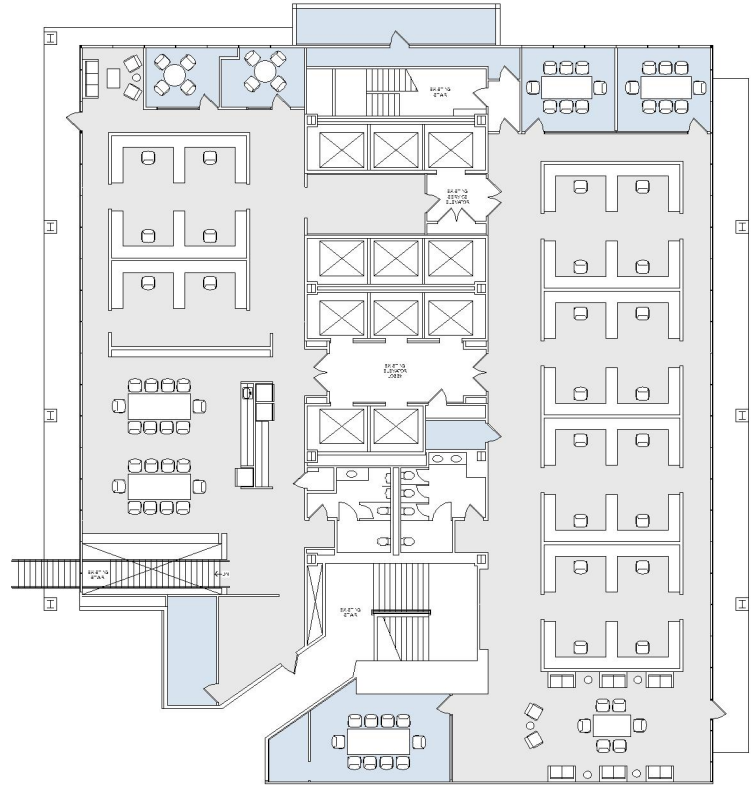

[ MEZZANINE ]


10,721 RSF

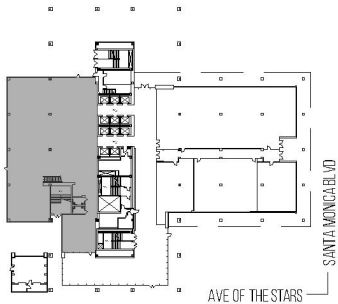

**AS-BUILT CONFIGURATION  
GROUND LEVEL**

OFFICES:	7
CONFERENCE ROOM:	2
RECEPTION:	1
KITCHENETTE:	1
PRIVATE RESTROOMS:	2
INTERNAL STAIRWELL	

NOT TO SCALE  
FURNITURE NOT INCLUDED

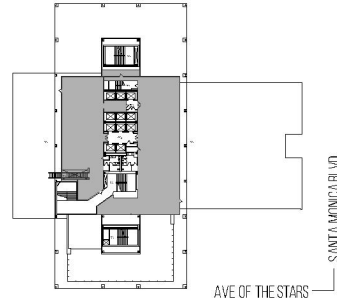

**AS-BUILT CONFIGURATION  
MEZZANINE**

BREAK ROOMS:	2
CONFERENCE ROOM:	3
RESTROOMS:	2
KITCHENETTE:	1
STORAGE ROOMS:	3
INTERNAL STAIRWELL	

NOT TO SCALE  
FURNITURE NOT INCLUDED

For more information, please contact:

310.255.7777

leasing@douglasemmett.com

