
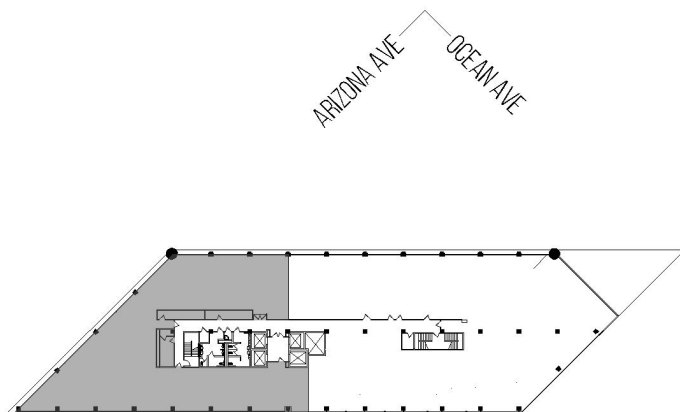


# 1299 OCEAN AVENUE

SUITE 620 | 7,919 RSF  
SANTA MONICA

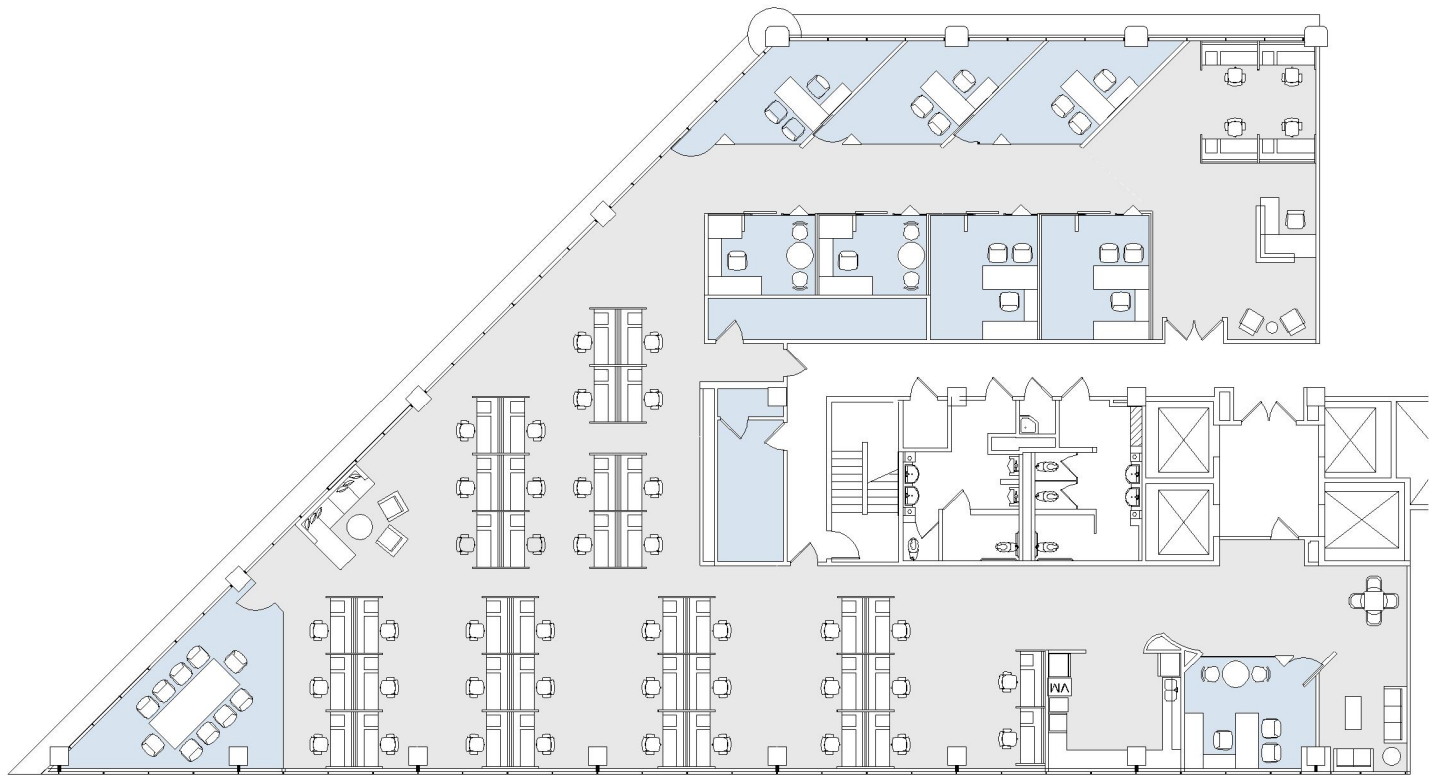

## AS-BUILT CONFIGURATION

OFFICES:	8
CONFERENCE ROOM:	1
RECEPTION:	1
KITCHEN:	1
STORAGE ROOM:	2

NOT TO SCALE  
FURNITURE NOT INCLUDED

For more information, please contact:

310.255.7777  
leasing@douglasemmett.com

**Douglas  
Emmett**