



55

HARBOR COURT - OFFICE

SUITE 1550 | 2,125 RSF

HONOLULU

MERCHANT STREET

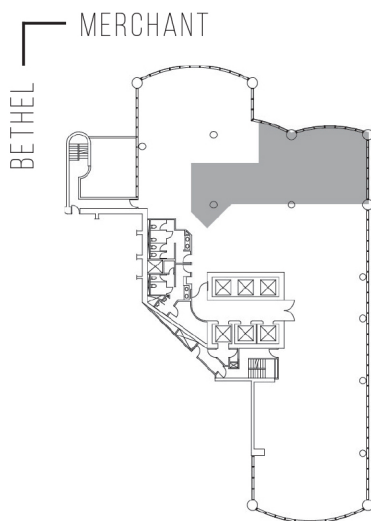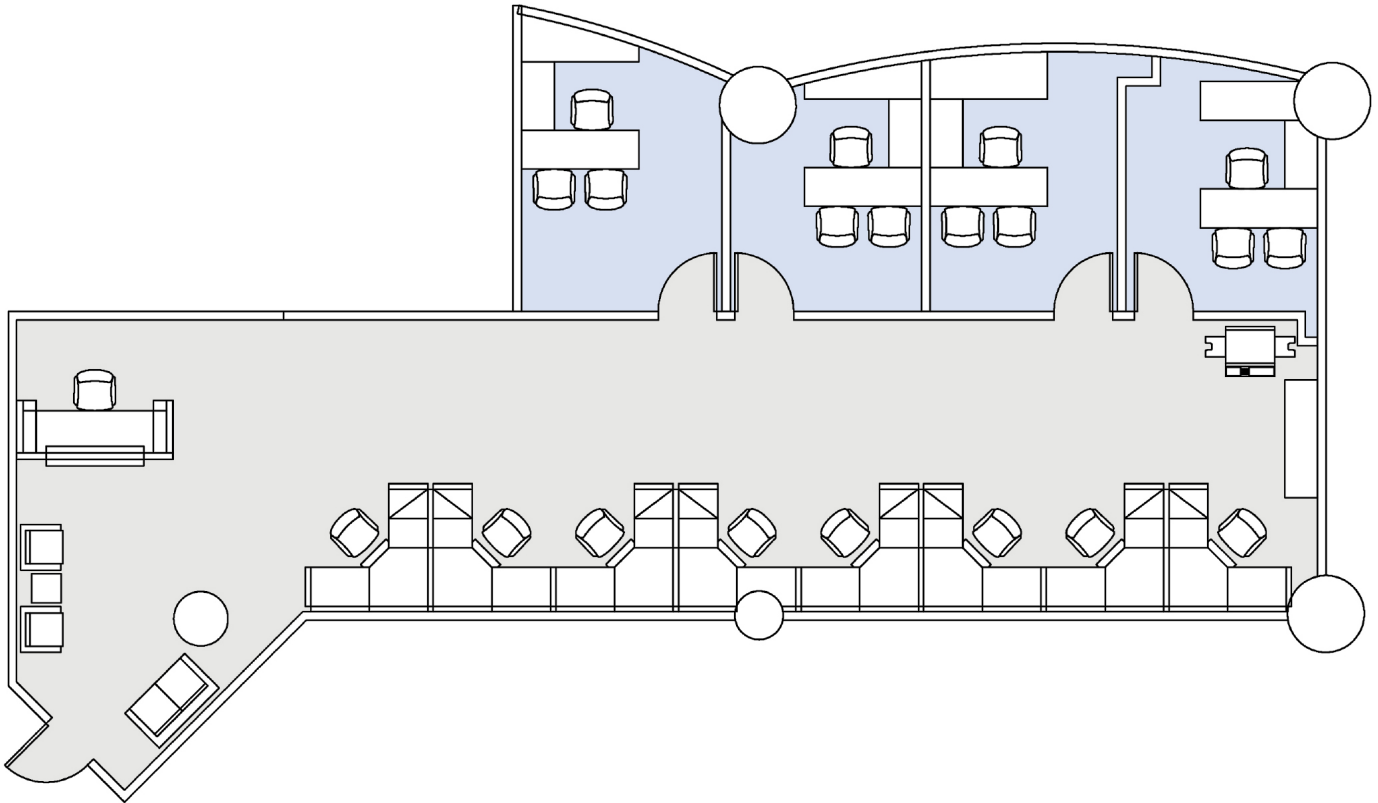

AS-BUILT CONFIGURATION

OFFICES:	4
WORKSTATIONS:	8
RECEPTION:	1

NOT TO SCALE
FURNITURE NOT INCLUDED

For more information, please contact:

310.255.7777

leasing@douglasemmett.com

**Douglas
Emmett**