
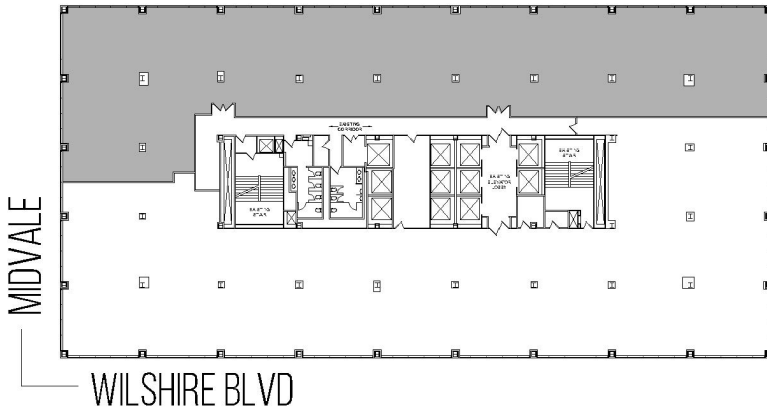


10960 WILSHIRE

SUITE 1150 | 10,711 RSF
WESTWOOD

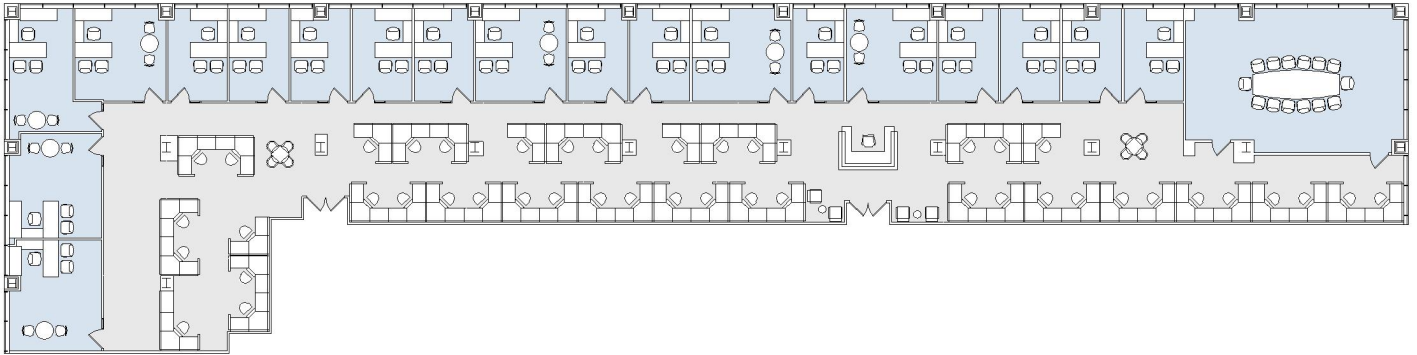

AS-BUILT CONFIGURATION

OFFICES:	19
CONFERENCE ROOM:	1
RECEPTION:	1

NOT TO SCALE
FURNITURE NOT INCLUDED

For more information, please contact:

310.255.7777
leasing@douglasemmett.com

**Douglas
Emmett**