



1100

WESTWOOD CENTER

SUITE 720 | 4,192 RSF

WESTWOOD

GLENDON AVENUE

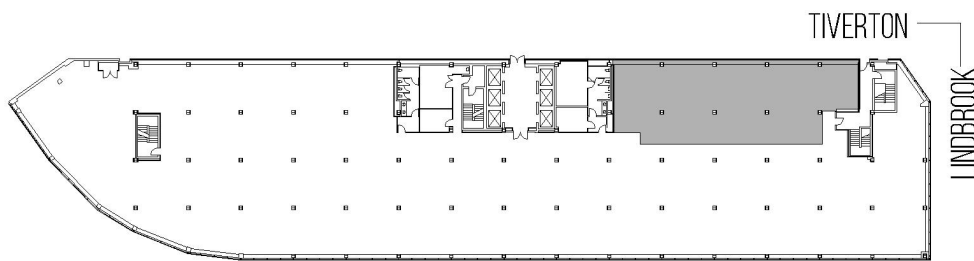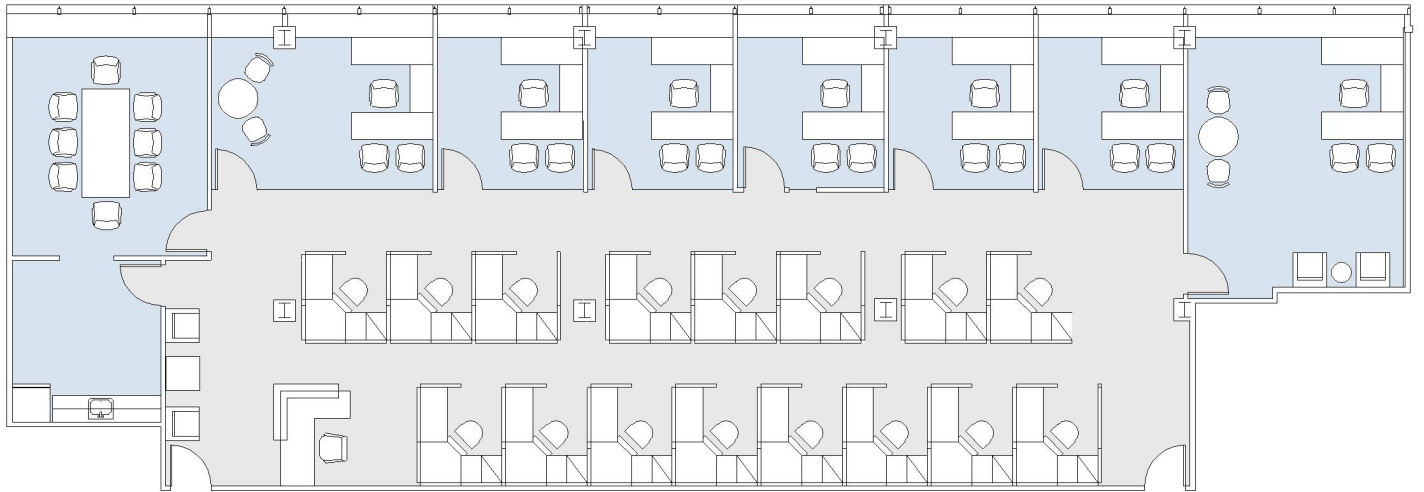

AS-BUILT CONFIGURATION

OFFICES:	7
CONFERENCE ROOM:	1
RECEPTION:	1
KITCHEN:	1

NOT TO SCALE
FURNITURE NOT INCLUDED

For more information, please contact:

310.255.7777

leasing@douglasemmett.com

**Douglas
Emmett**