

15821 VENTURA

ENCINO TERRACE

SUITE 670 | 15,142 RSF


SHERMAN OAKS/ENCINO



AS-BUILT CONFIGURATION

OFFICES:	20
CONFERENCE ROOM:	4
RECEPTION:	1
KITCHEN:	1
STORAGE ROOM:	2
IT ROOMS:	1
FILE ROOM:	2

NOT TO SCALE
FURNITURE NOT INCLUDED

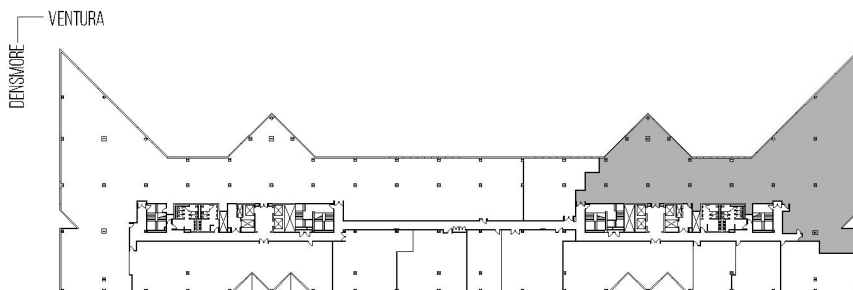

For more information, please contact:

310.255.7777

leasing@douglasemmett.com

**Douglas
Emmett**