



# 1990

CORNERSTONE PLAZA

SUITE 440 | 1,238 RSF

SAWTELLE/WEST LA

## SOUTH BUNDY

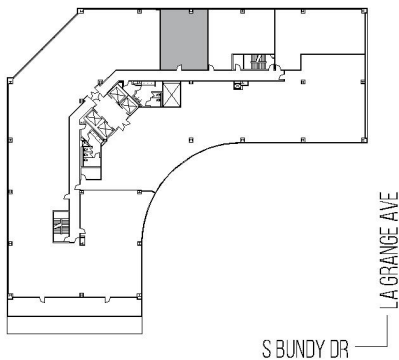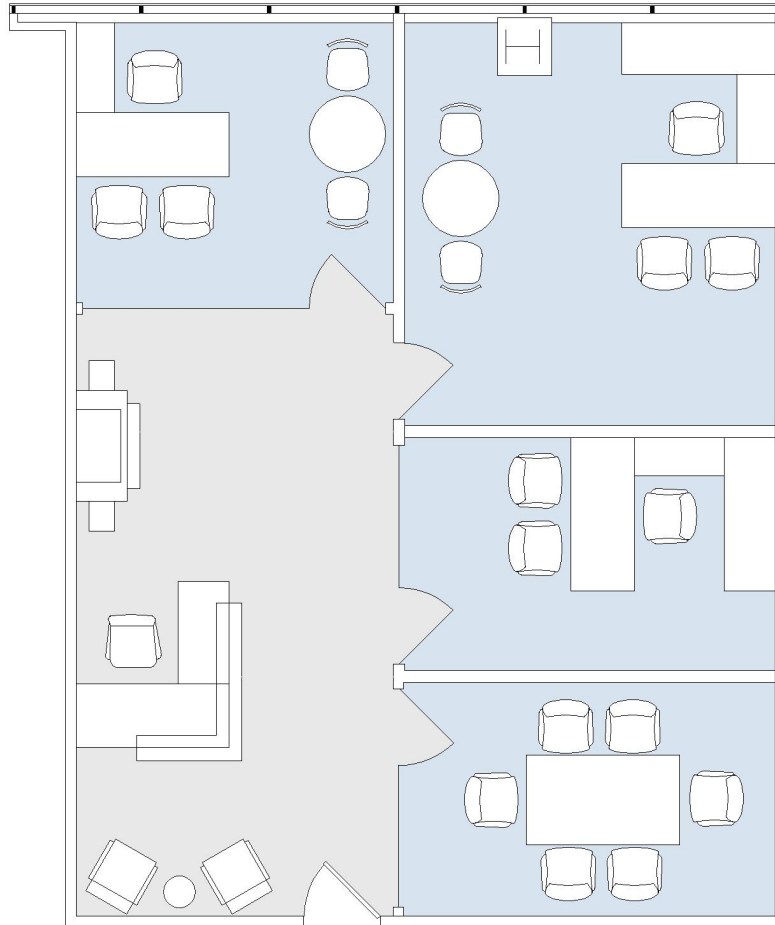

### AS-BUILT CONFIGURATION

OFFICES:	3
CONFERENCE ROOM:	1
RECEPTION:	1

NOT TO SCALE  
FURNITURE NOT INCLUDED

For more information, please contact:

310.255.7777

leasing@douglasemmett.com

**Douglas  
Emmett**