

# 401 WILSHIRE

SUITE 820 | 8,625 RSF

SANTA MONICA




#### AS-BUILT CONFIGURATION

OFFICES:	14
CONFERENCE ROOM:	2
RECEPTION:	1
KITCHEN:	1
STORAGE ROOM:	1
FILING ROOM:	1

NOT TO SCALE

FURNITURE NOT INCLUDED

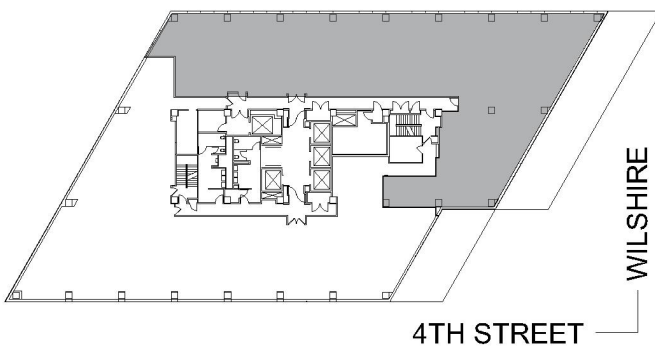

For more information, please contact:

310.255.7777  
leasing@douglasemmett.com

**Douglas  
Emmett**