
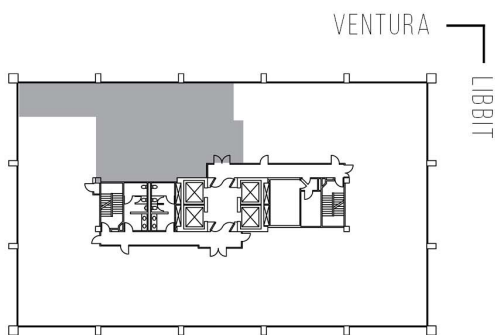


16255 VENTURA

MB PLAZA

SUITE 440 | 2,807 RSF

SHERMAN OAKS/ENCINO

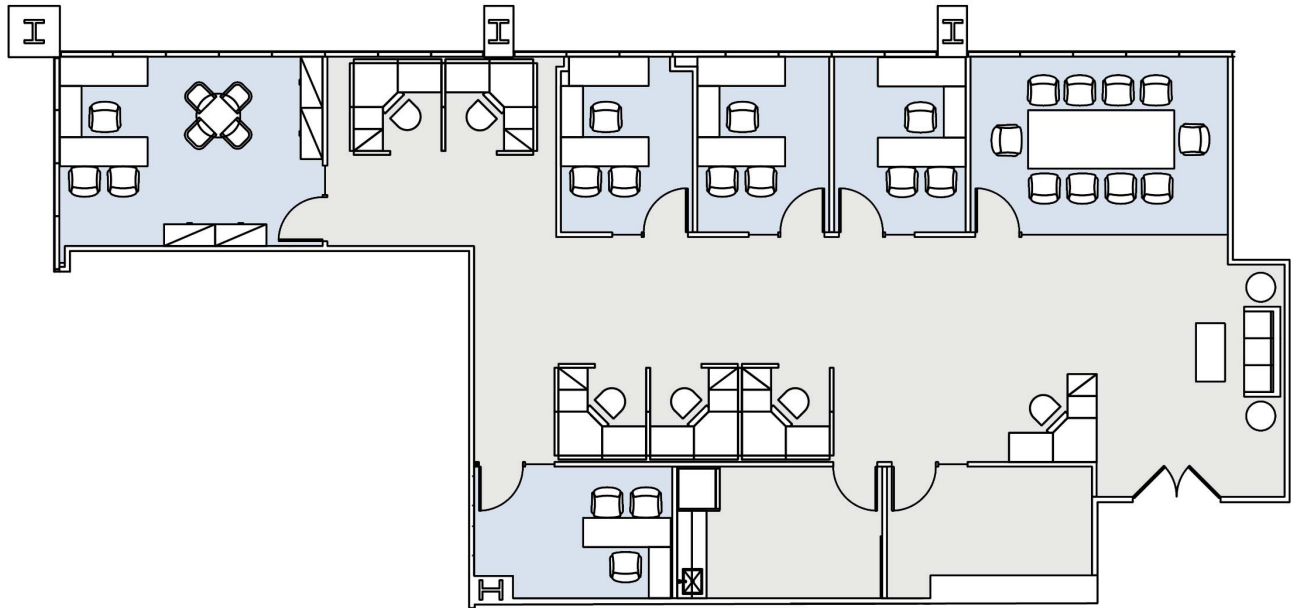

AS-BUILT CONFIGURATION

OFFICES:	5
CONFERENCE ROOM:	1
RECEPTION:	1
KITCHEN:	1
STORAGE ROOM:	1

NOT TO SCALE
FURNITURE NOT INCLUDED

For more information, please contact:

310.255.7777

leasing@douglasemmett.com

**Douglas
Emmett**