
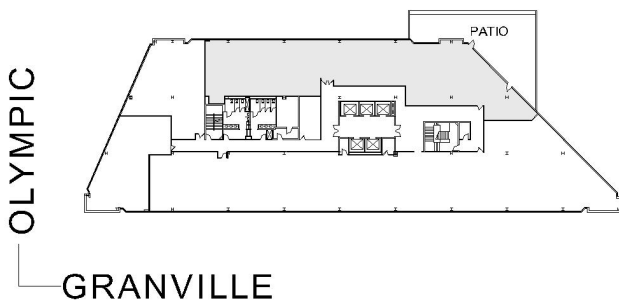


11835 OLYMPIC

WESTSIDE TOWERS EAST TOWER

SUITE 550 | 6,265 RSF

SAWTELLE/WEST LA

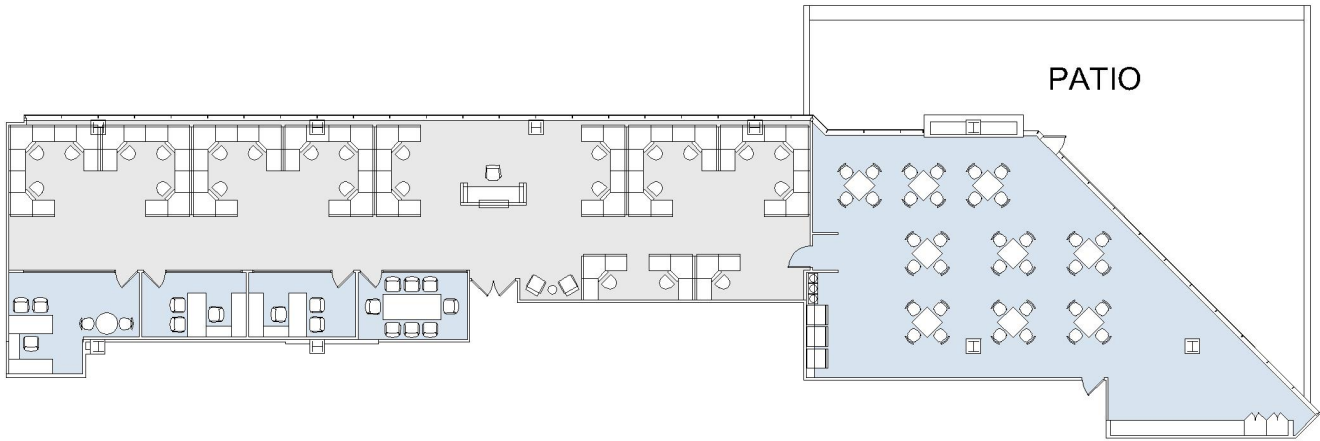

AS-BUILT CONFIGURATION

OFFICES:	3
CONFERENCE ROOM:	1
RECEPTION:	1
KITCHEN:	1

NOT TO SCALE
FURNITURE NOT INCLUDED

For more information, please contact:

310.255.7777
leasing@douglasemmett.com

**Douglas
Emmett**