
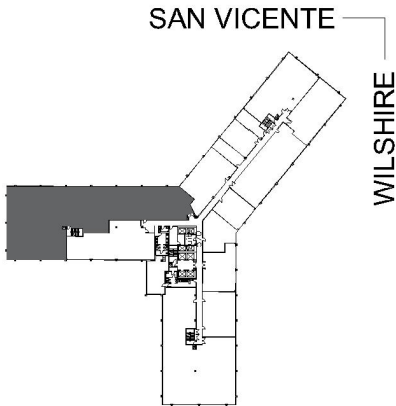


8383 WILSHIRE

SUITE 500 | 11,642 RSF
BEVERLY HILLS

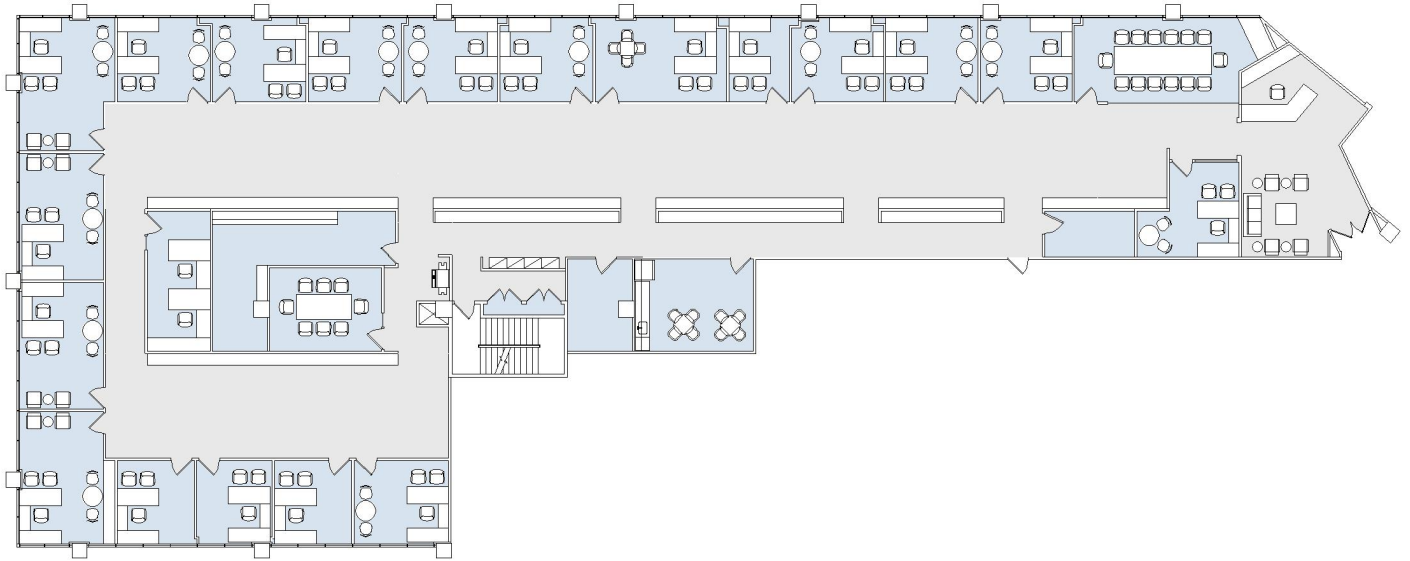

AS-BUILT CONFIGURATION

OFFICES:	20
CONFERENCE ROOM:	2
RECEPTION:	1
KITCHEN:	1
IT ROOM:	1
FILE ROOM:	1
STORAGE:	2

NOT TO SCALE
FURNITURE NOT INCLUDED

For more information, please contact:

310.255.7777
leasing@douglasemmett.com

**Douglas
Emmett**