
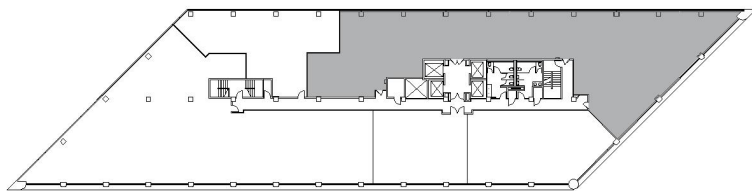


# 1299 OCEAN AVENUE

SUITE 450 | 7,340 RSF  
SANTA MONICA

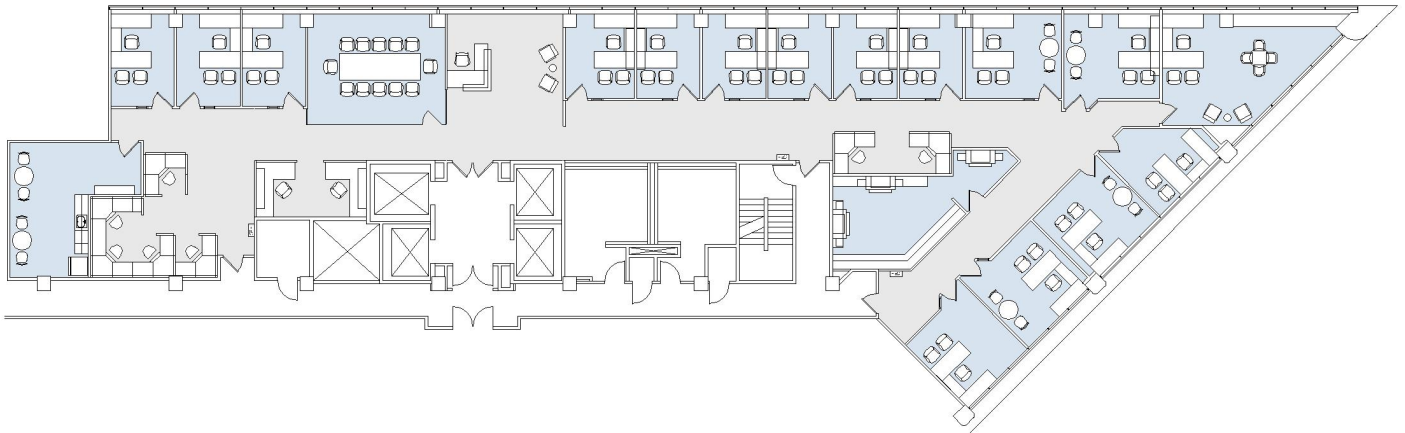

OCEAN  
ARIZONA

#### AS-BUILT CONFIGURATION

|                  |    |
|------------------|----|
| OFFICES:         | 16 |
| CONFERENCE ROOM: | 1  |
| RECEPTION:       | 1  |
| KITCHEN:         | 1  |
| COPY ROOM:       | 1  |

NOT TO SCALE

FURNITURE NOT INCLUDED

For more information, please contact:

310.255.7777  
leasing@douglasemmett.com

**Douglas  
Emmett**