


11835 OLYMPIC

WESTSIDE TOWERS EAST TOWER

SUITE 1135 | 1,324 RSF


SAWTELLE/WEST LA

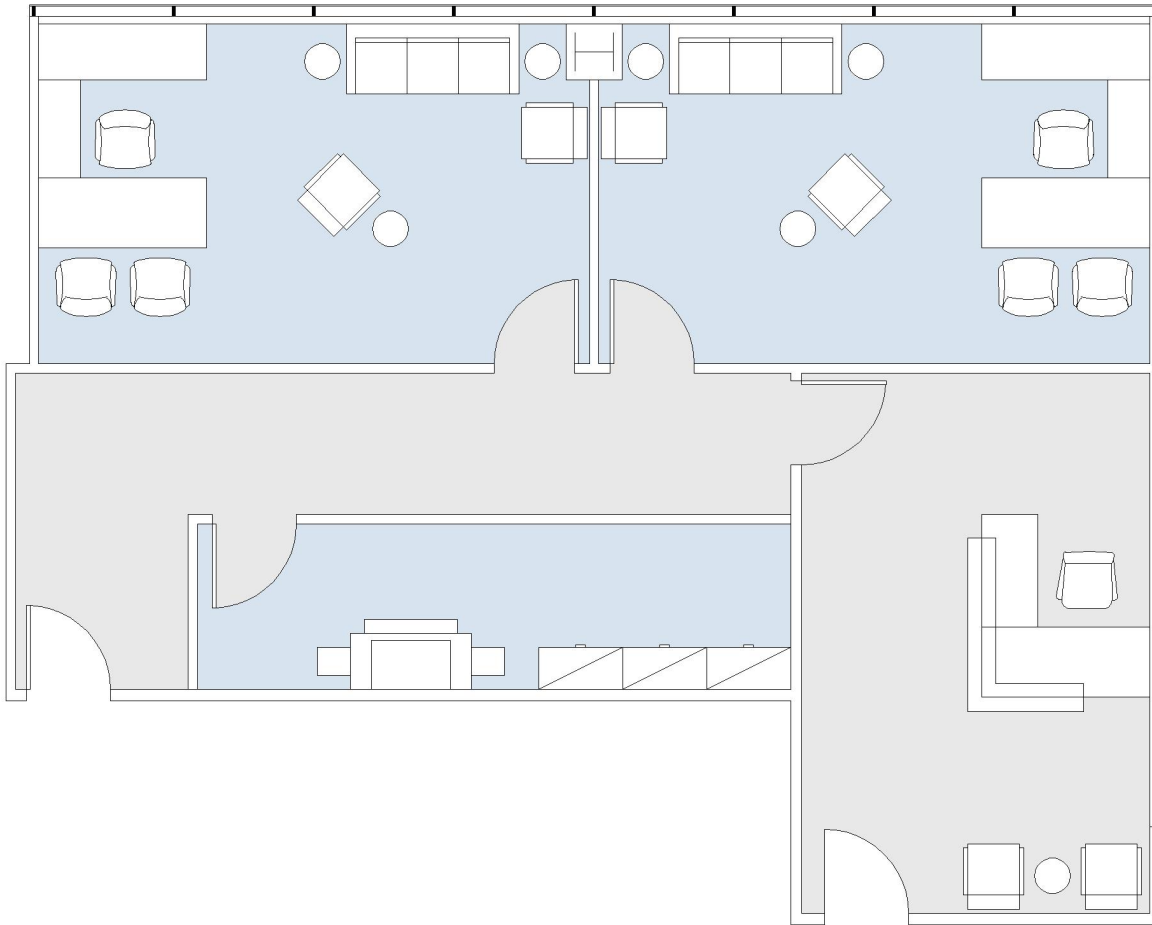

AS-BUILT CONFIGURATION

OFFICES:	2
RECEPTION:	1
COPY / STORAGE ROOM:	1

NOT TO SCALE
FURNITURE NOT INCLUDED

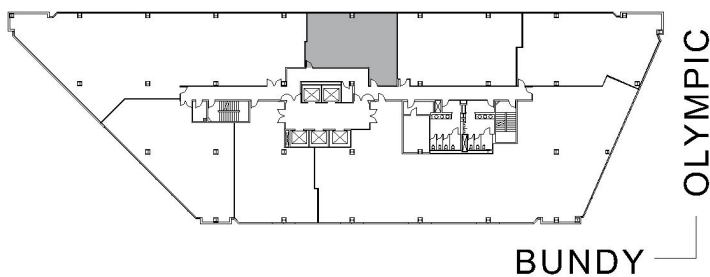

For more information, please contact:

310.255.7777
leasing@douglasemmett.com

**Douglas
Emmett**