



1990

CORNERSTONE PLAZA

SUITE 375 | 2,169 RSF

SAWTELLE/WEST LA

SOUTH BUNDY

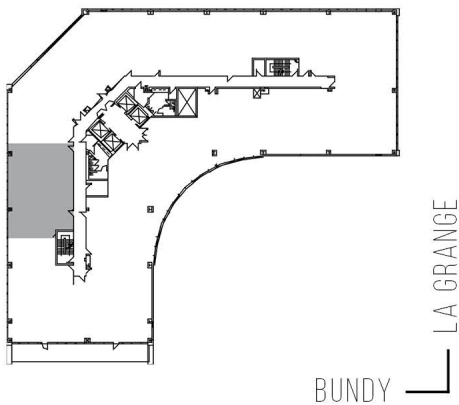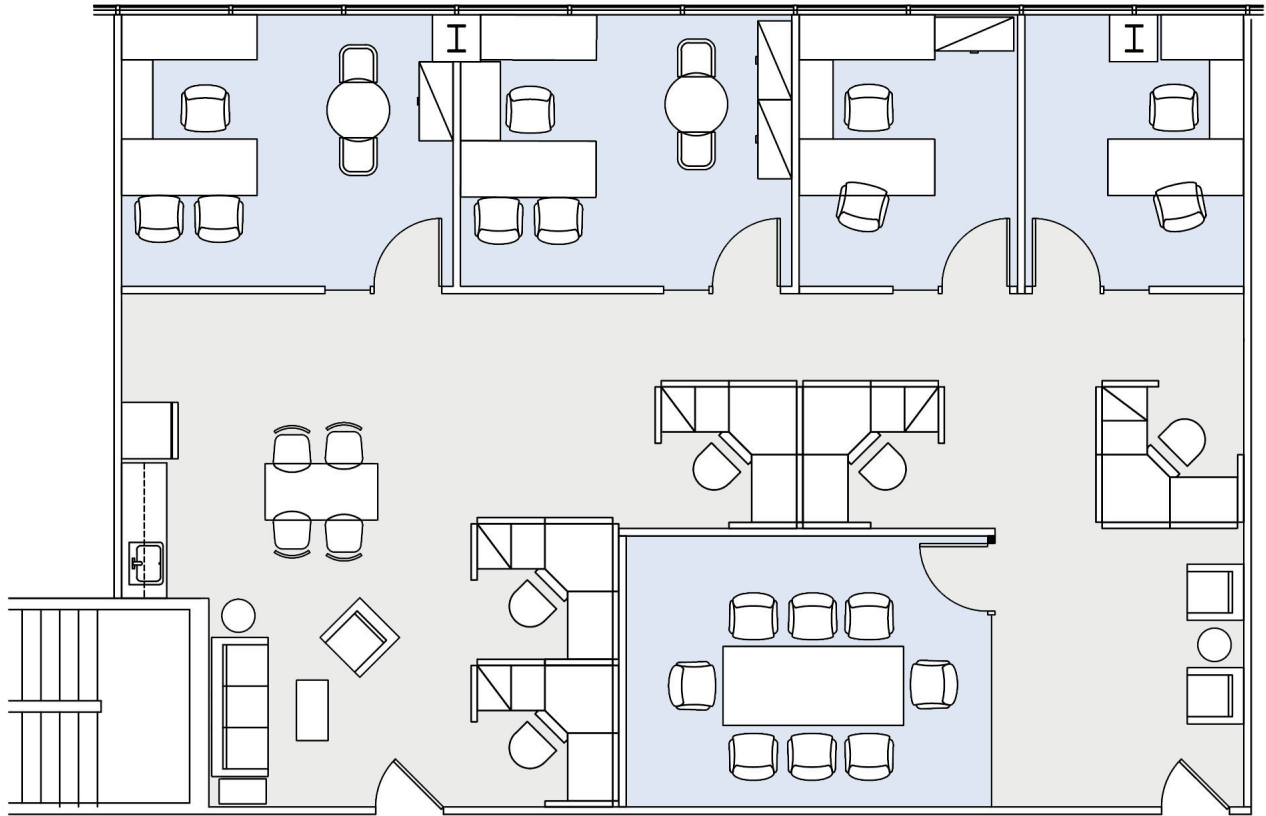

AS-BUILT CONFIGURATION

OFFICES:	4
RECEPTION:	1
CONFERENCE ROOM:	1
KITCHENETTE:	1

NOT TO SCALE
FURNITURE NOT INCLUDED

For more information, please contact:

310.255.7777

leasing@douglasemmett.com

**Douglas
Emmett**