
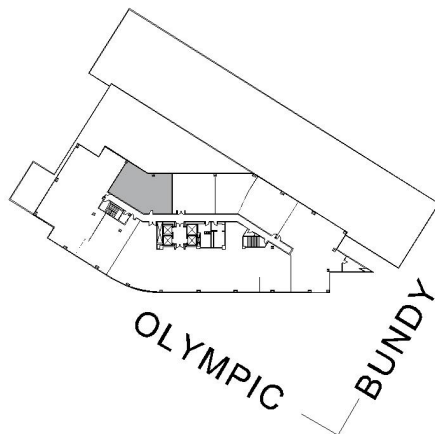


11900 OLYMPIC

BUNDY/OLYMPIC

SUITE 540 | 1,818 RSF

SAWTELLE/WEST LA

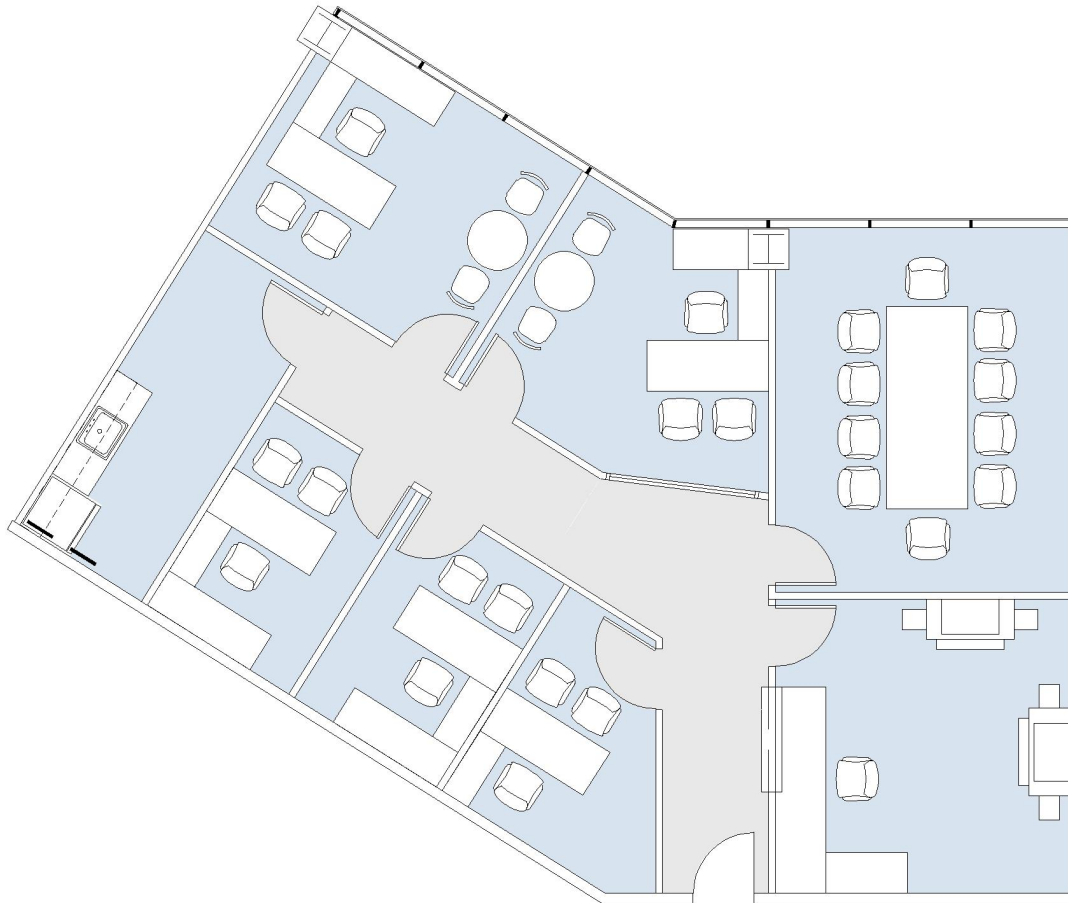

AS-BUILT CONFIGURATION

OFFICES:	5
CONFERENCE ROOM:	1
RECEPTION:	1
KITCHEN:	1

NOT TO SCALE

FURNITURE NOT INCLUDED

For more information, please contact:

310.255.7777
leasing@douglasemmett.com

**Douglas
Emmett**