
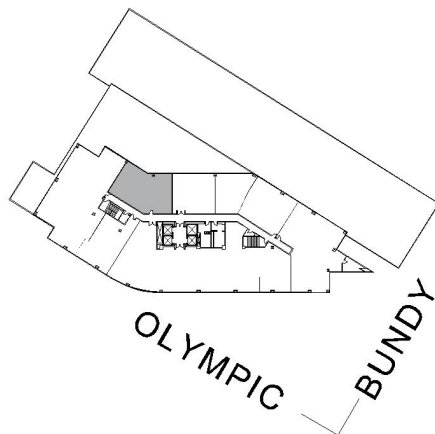


11900 OLYMPIC

BUNDY/OLYMPIC

SUITE 540 | 1,818 RSF

SAWTELLE/WEST LA

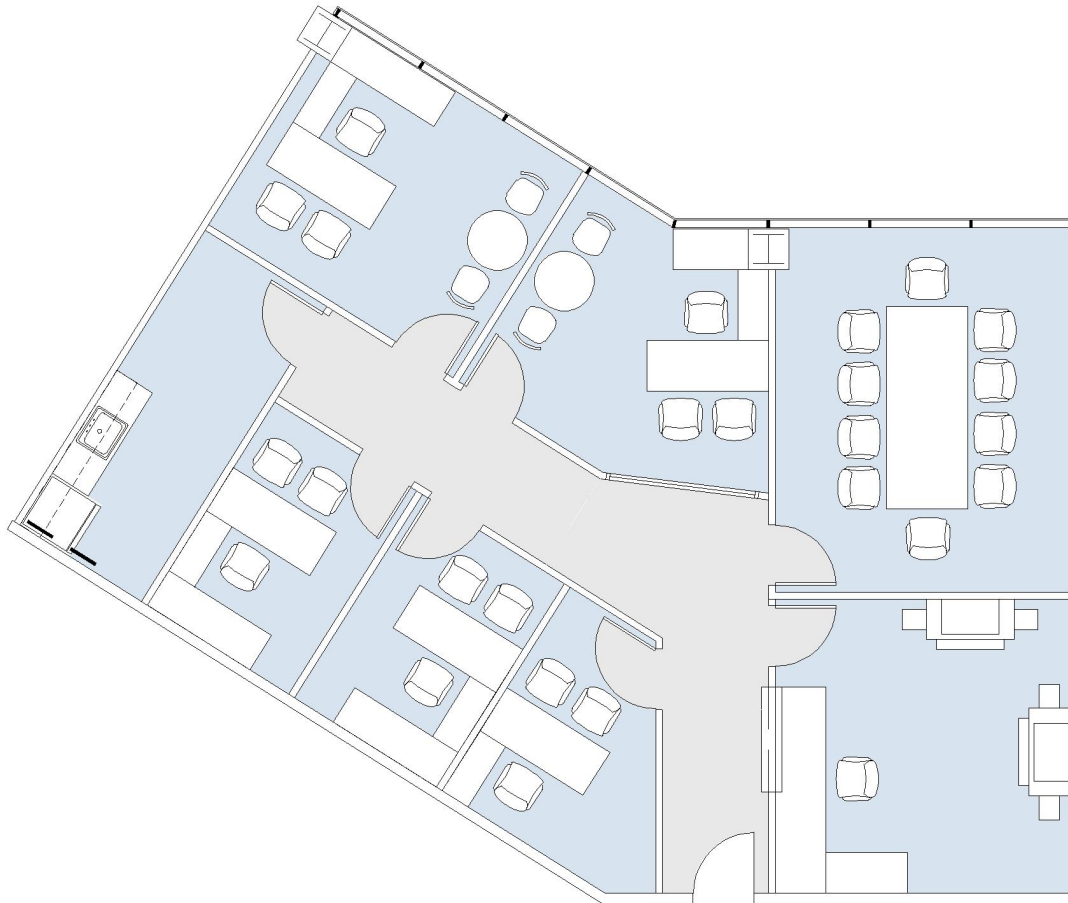

AS-BUILT CONFIGURATION

| | |
|------------------|---|
| OFFICES: | 5 |
| CONFERENCE ROOM: | 1 |
| RECEPTION: | 1 |
| KITCHEN: | 1 |

NOT TO SCALE

FURNITURE NOT INCLUDED

For more information, please contact:

310.255.7777

leasing@douglasemmett.com

**Douglas
Emmett**