


# 12400 WILSHIRE

SUITE 905 | 2,845 RSF  
BRENTWOOD-WILSHIRE

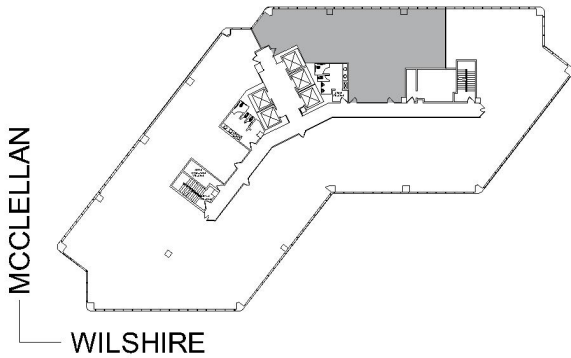

#### AS-BUILT CONFIGURATION

OFFICES:	8
CONFERENCE ROOM:	1
RECEPTION:	1

NOT TO SCALE  
FURNITURE NOT INCLUDED

For more information, please contact:

310.255.7777  
leasing@douglasemmett.com

**Douglas  
Emmett**