
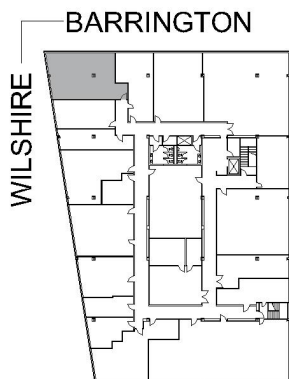


11704 WILSHIRE

BARRINGTON PLAZA - COMMERCIAL

SUITE 250 | 1,066 RSF

BRENTWOOD-WILSHIRE

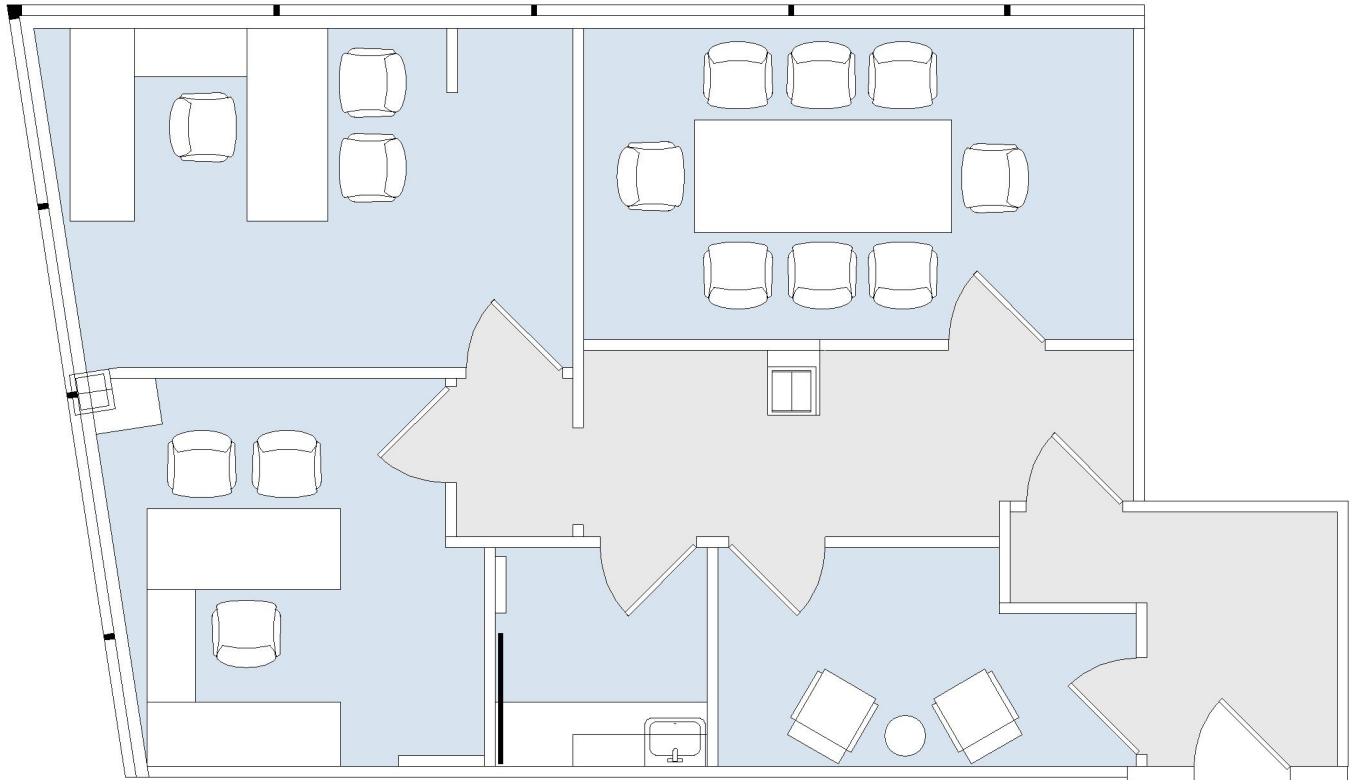

AS-BUILT CONFIGURATION

OFFICES:	2
CONFERENCE ROOM:	1
WAITING ROOM:	1
KITCHEN:	1

NOT TO SCALE

FURNITURE NOT INCLUDED

For more information, please contact:

310.255.7777

leasing@douglasemmett.com

**Douglas
Emmett**