



21650

WARNER CENTER TOWER - III

SUITE 140 | 2,680 RSF

WOODLAND HILLS

OXNARD STREET

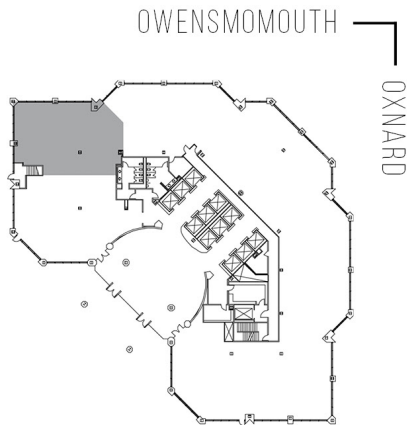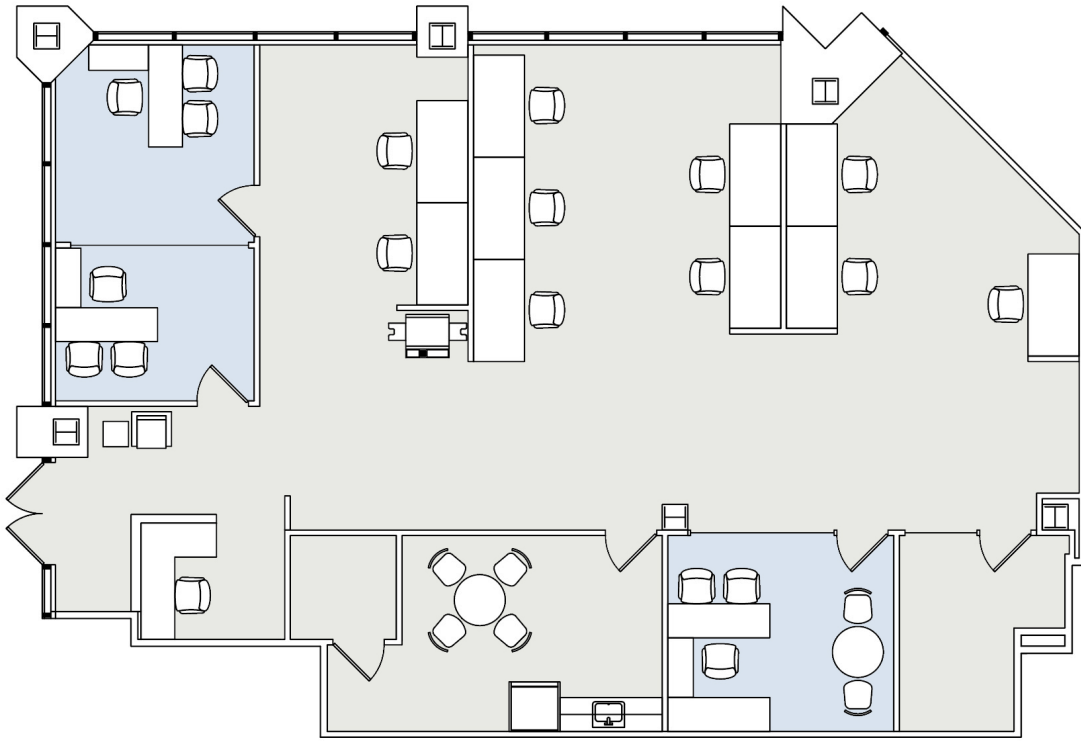

AS-BUILT CONFIGURATION

OFFICES:	3
RECEPTION:	1
KITCHEN:	1
STORAGE ROOMS:	2

NOT TO SCALE
FURNITURE NOT INCLUDED

For more information, please contact:

310.255.7777

leasing@douglasemmett.com

**Douglas
Emmett**