
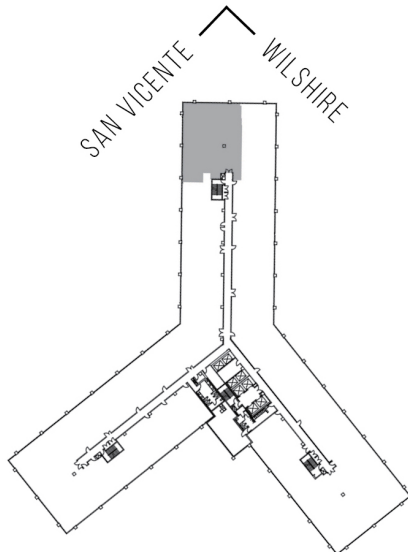


8383

WILSHIRE

SUITE 335 | 3,706 RSF

BEVERLY HILLS

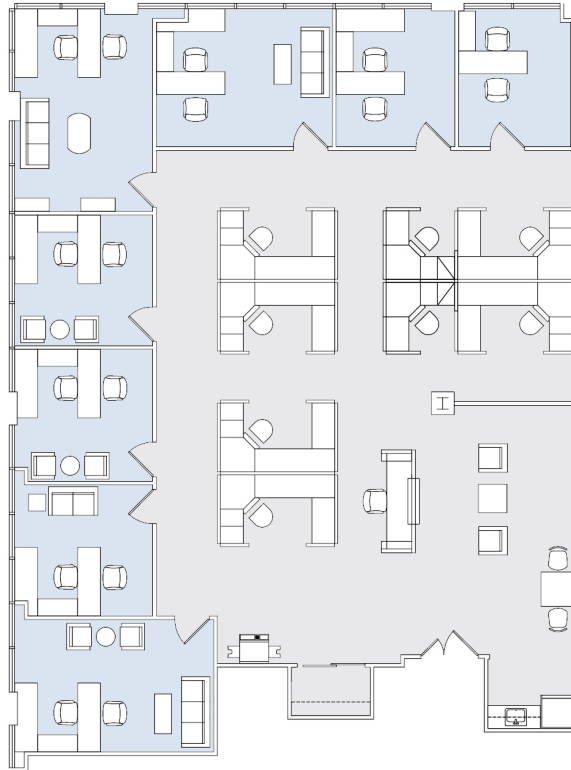

AS-BUILT CONFIGURATION

OFFICES:	8
RECEPTION:	1
KITCHEN:	1
OPEN OFFICE:	1
STORAGE CLOSET:	1

ADJUSTED FOR SOCIAL DISTANCING  
NOT TO SCALE  
FURNITURE NOT INCLUDED

For more information, please contact:

310.255.7777  
leasing@douglasemmett.com

**Douglas  
Emmett**