



# 21550

WARNER CENTER TOWER - II

SUITE 430 | 1,905 RSF

WOODLAND HILLS

## OXNARD STREET

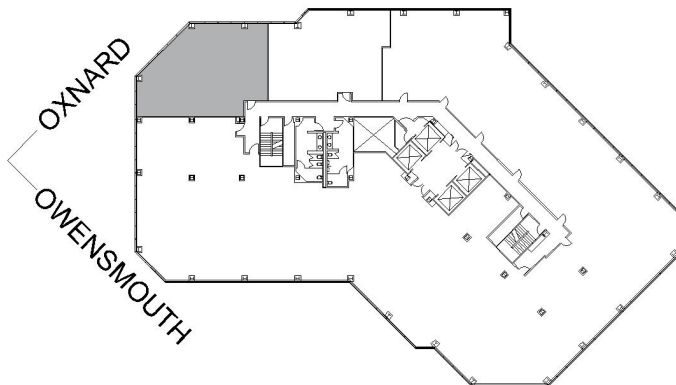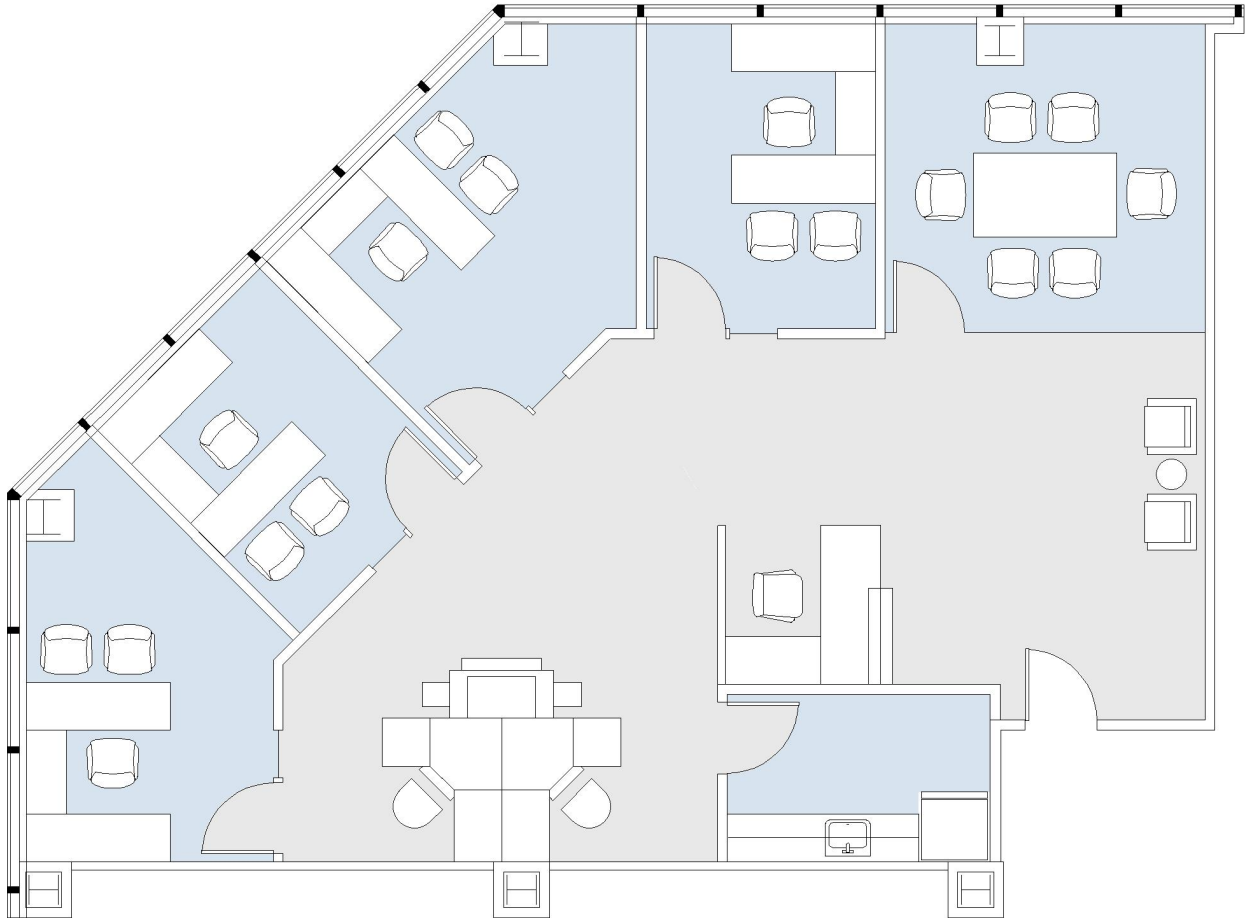

### AS-BUILT CONFIGURATION

OFFICES:	4
CONFERENCE ROOM:	1
RECEPTION:	1
KITCHEN:	1

NOT TO SCALE

FURNITURE NOT INCLUDED

For more information, please contact:

310.255.7777

leasing@douglasemmett.com

**Douglas  
Emmett**