


9100 WILSHIRE

9100 WILSHIRE EAST TOWER

SUITE 250 | 2,617 RSF

BEVERLY HILLS

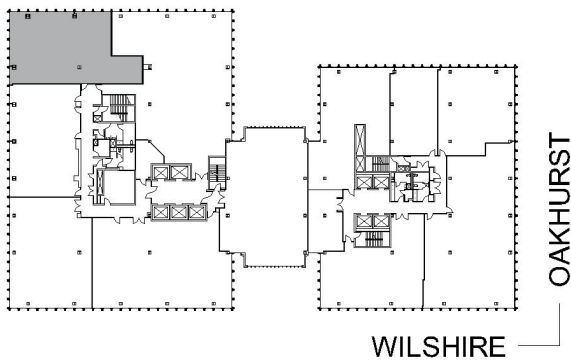

AS-BUILT CONFIGURATION

OFFICES:	3
CONFERENCE ROOM:	1
RECEPTION:	1
KITCHEN:	1

NOT TO SCALE

FURNITURE NOT INCLUDED

For more information, please contact:

310.255.7777

leasing@douglasemmett.com

**Douglas
Emmett**