



1990

CORNERSTONE PLAZA

SUITE 520 | 2,486 RSF

SAWTELLE/WEST LA

SOUTH BUNDY

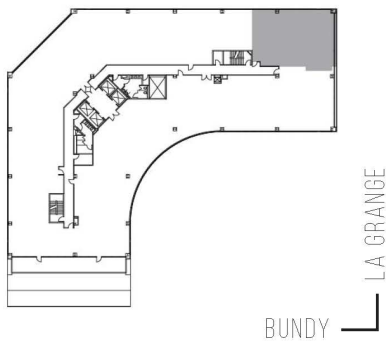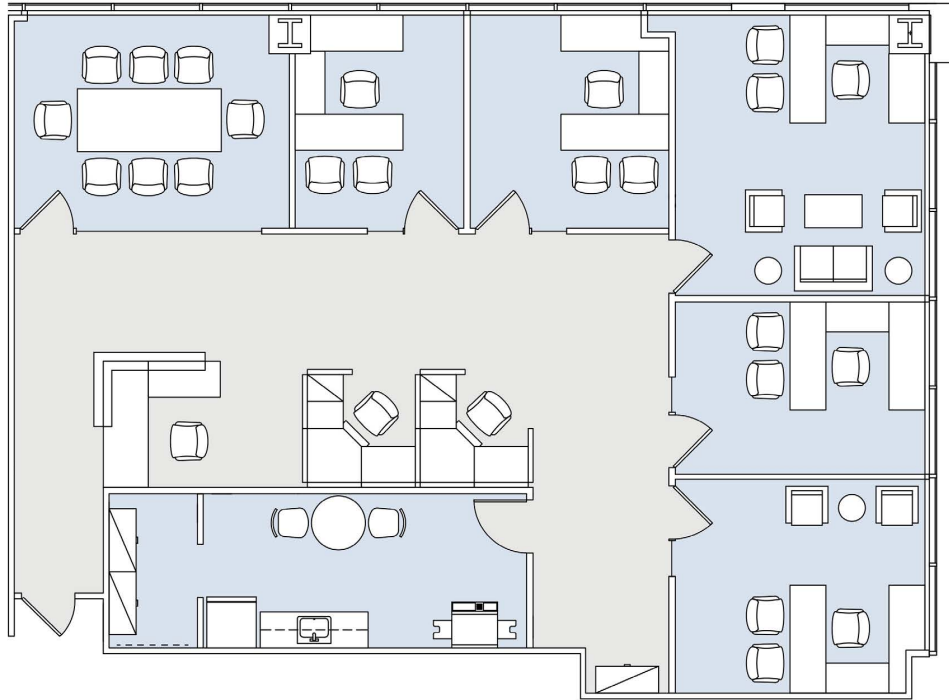

AS-BUILT CONFIGURATION

| | |
|------------------|---|
| OFFICES: | 5 |
| WORKSTATIONS: | 2 |
| RECEPTION: | 1 |
| CONFERENCE ROOM: | 1 |
| KITCHEN: | 1 |

NOT TO SCALE
FURNITURE NOT INCLUDED

For more information, please contact:

310.255.7777

leasing@douglasemmett.com

**Douglas
Emmett**