
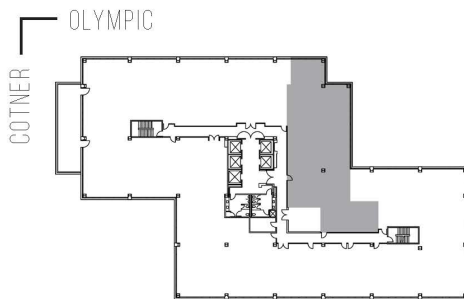


11150 W OLYMPIC

OLYMPIC CENTER

SUITE 800 | 4,496 RSF

SAWTELLE/WEST LA

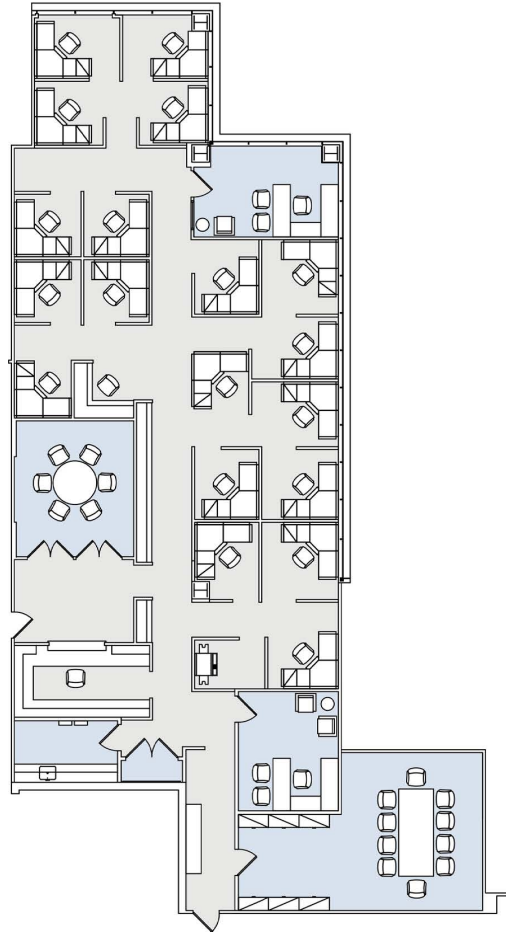

AS-BUILT CONFIGURATION

OFFICES:	2
WORKSTATIONS:	20
RECEPTION:	1
CONFERENCE ROOMS:	2
KITCHEN:	1

NOT TO SCALE
FURNITURE NOT INCLUDED

For more information, please contact:

310.255.7777
leasing@douglasemmett.com

**Douglas
Emmett**