
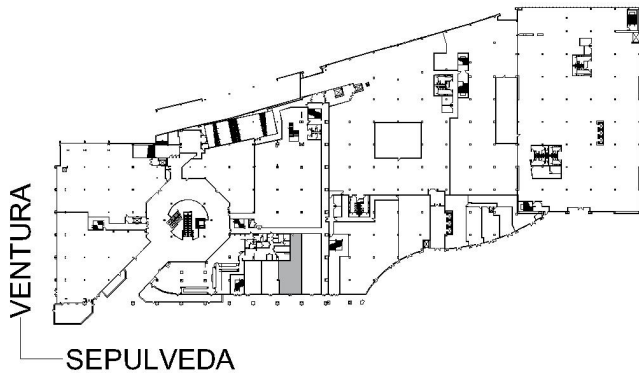


15301
VENTURA

SOG-RETAIL BUILDING

SUITE P12 | 1,913 RSF

SHERMAN OAKS/ENCINO

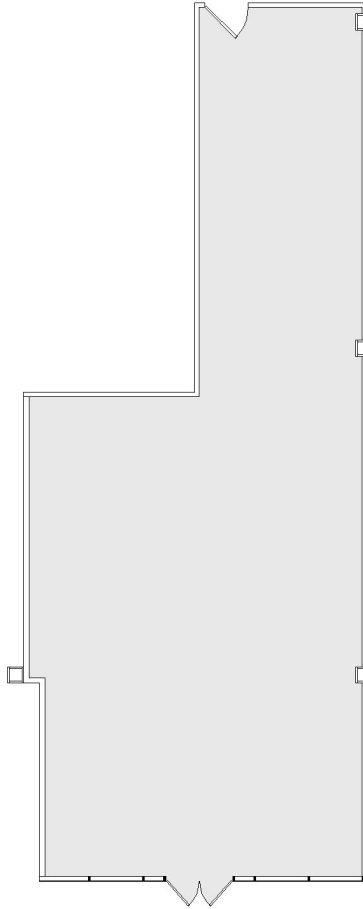

AS-BUILT CONFIGURATION

RAW SPACE

NOT TO SCALE

For more information, please contact:

310.255.7777
leasing@douglasemmett.com

**Douglas
Emmett**