


12400 WILSHIRE

SUITE 850 | 5,489 RSF
BRENTWOOD-WILSHIRE

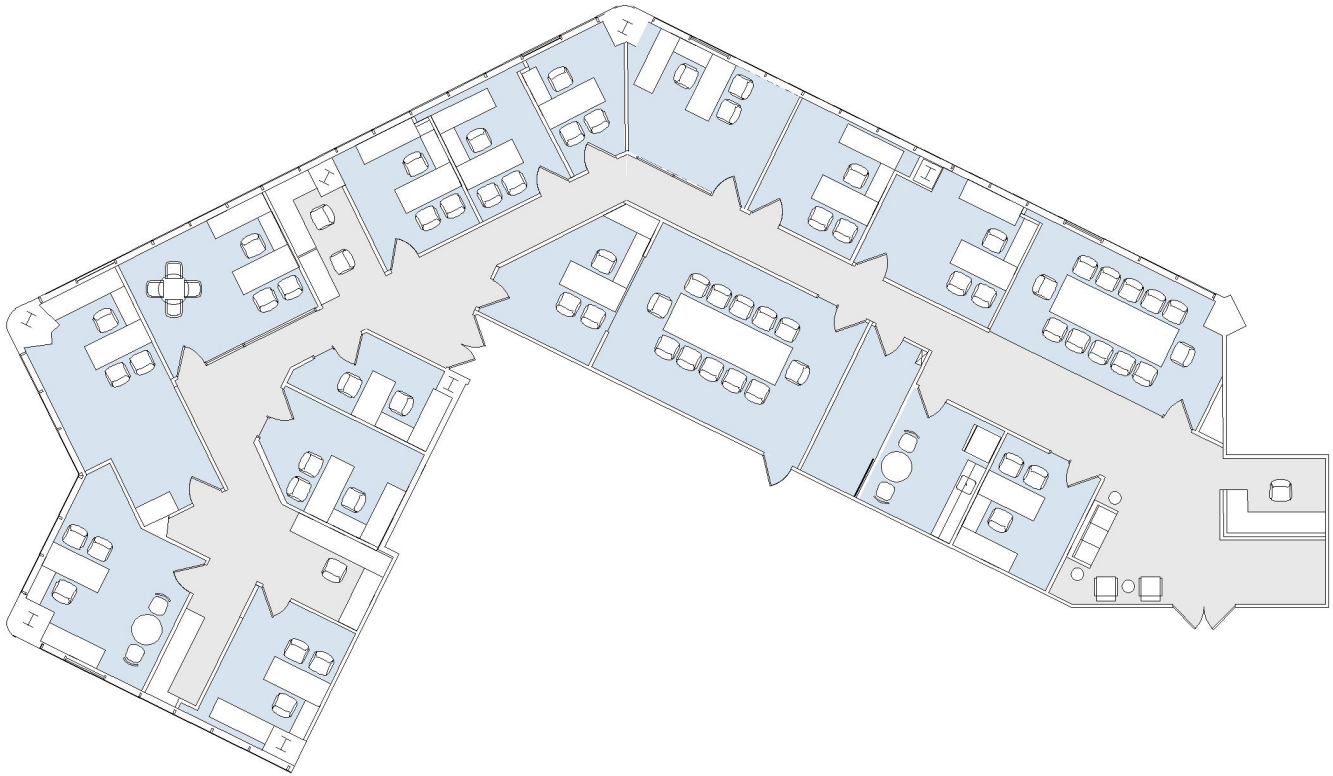


AS-BUILT CONFIGURATION

OFFICES:	14
CONFERENCE ROOM:	2
RECEPTION:	1
KITCHEN:	1
IT ROOM:	1

NOT TO SCALE

FURNITURE NOT INCLUDED

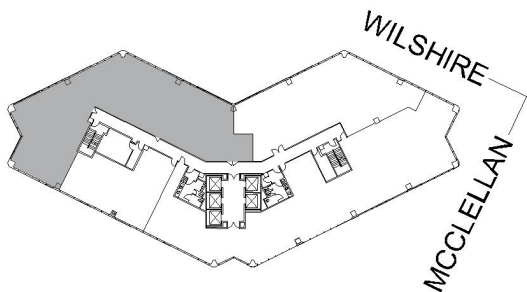

For more information, please contact:

310.255.7777
leasing@douglasemmett.com

**Douglas
Emmett**