
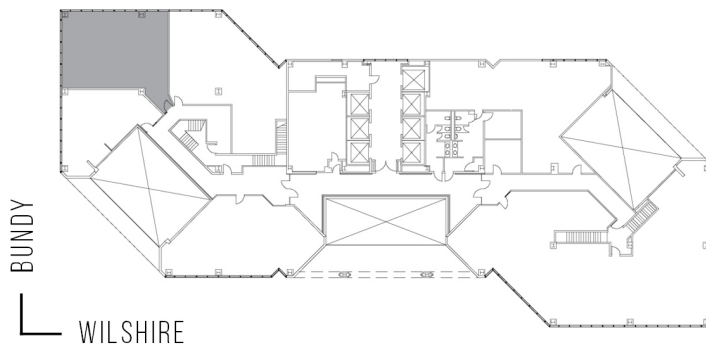


# 12100 WILSHIRE

SUITE M30 | 1,696 RSF  
BRENTWOOD-WILSHIRE

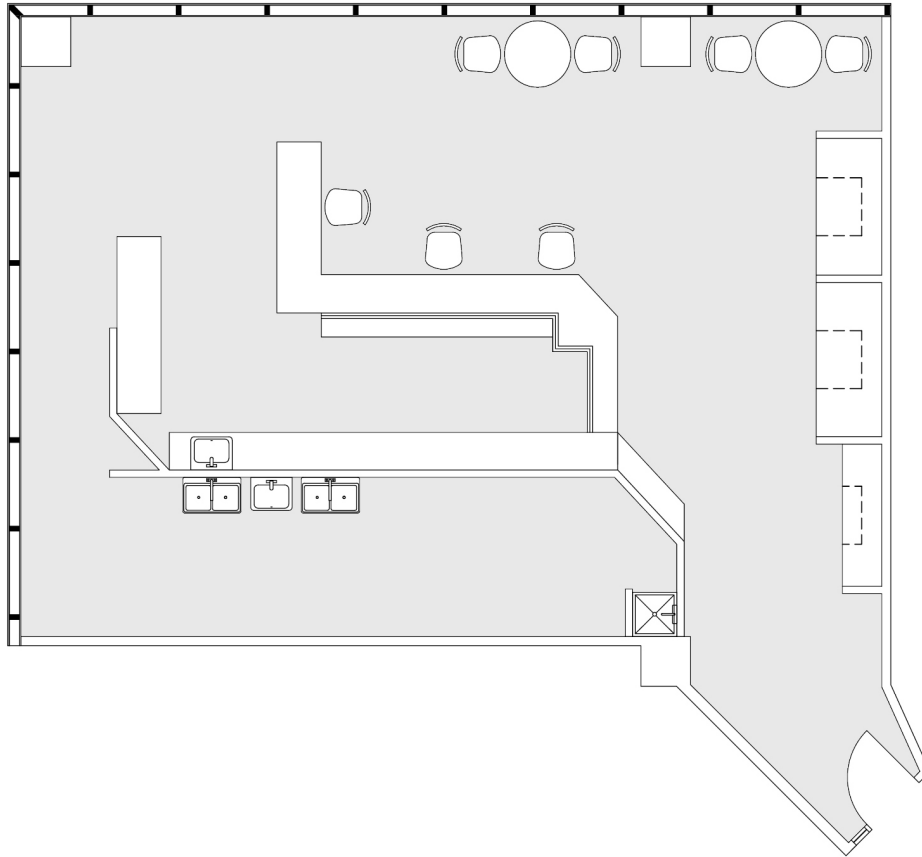

#### AS-BUILT CONFIGURATION

DINNING AREA:	1
PREP AREA:	1
KITCHEN AREA:	1

ADJUSTED FOR SOCIAL DISTANCING  
NOT TO SCALE  
FURNITURE NOT INCLUDED

For more information, please contact:

310.255.7777  
leasing@douglasemmett.com

**Douglas  
Emmett**