
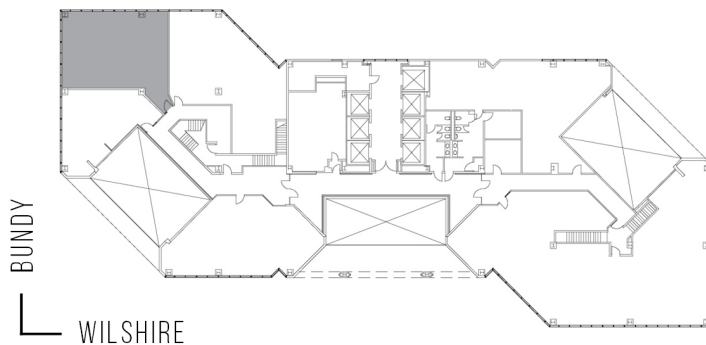


12100 WILSHIRE

SUITE M30 | 1,696 RSF
BRENTWOOD-WILSHIRE

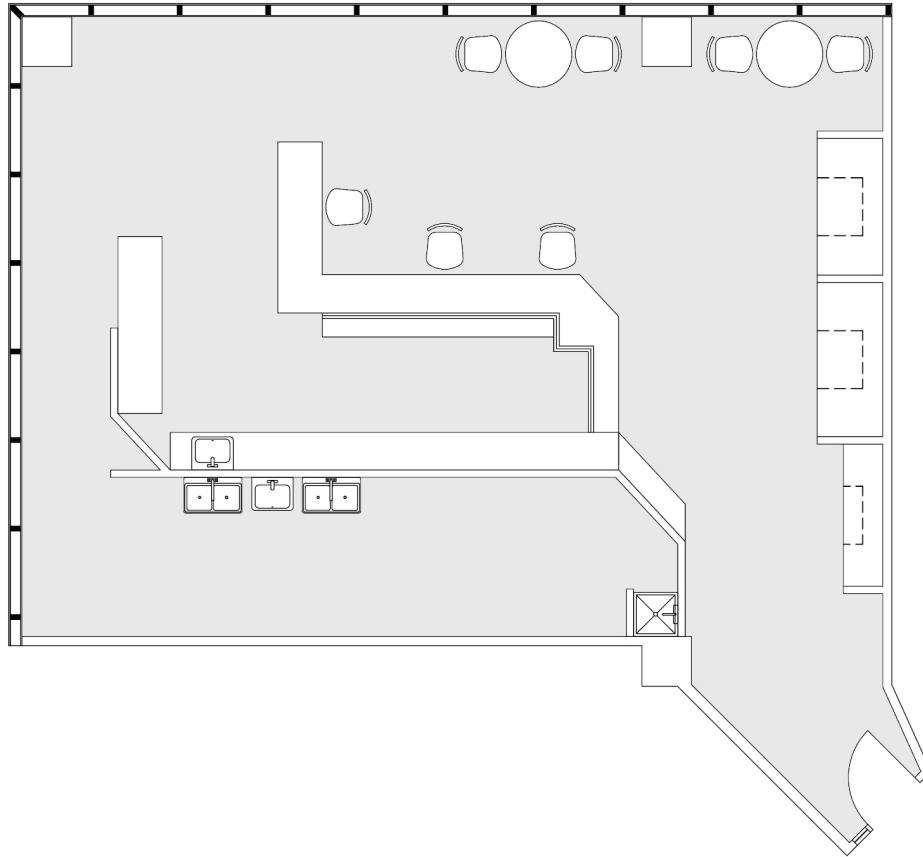

AS-BUILT CONFIGURATION

DINNING AREA:	1
PREP AREA:	1
KITCHEN AREA:	1

ADJUSTED FOR SOCIAL DISTANCING
NOT TO SCALE
FURNITURE NOT INCLUDED

For more information, please contact:

310.255.7777
leasing@douglasemmett.com

**Douglas
Emmett**