
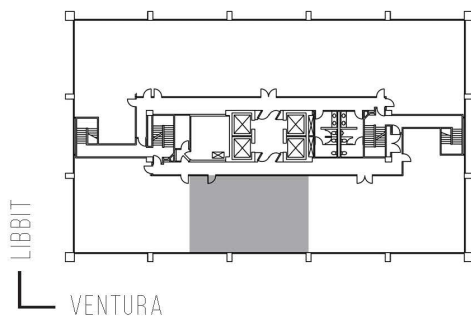


# 16255 VENTURA

MB PLAZA

SUITE 240 | 1,724 RSF

SHERMAN OAKS/ENCINO

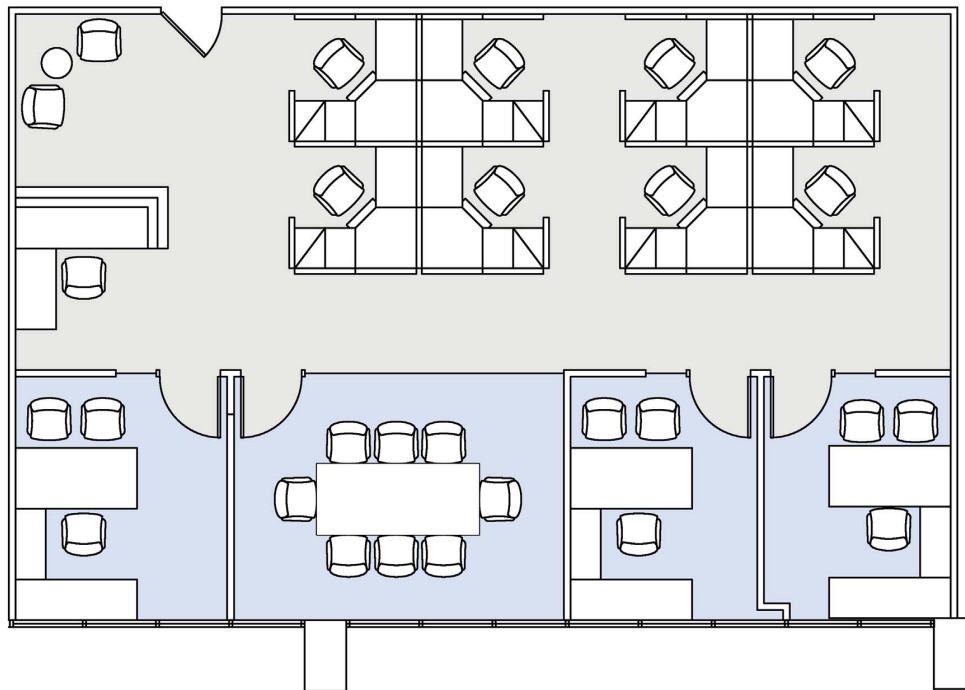

#### AS-BUILT CONFIGURATION

OFFICES:	3
WORKSTATIONS:	8
RECEPTION:	1
CONFERENCE ROOM:	1

NOT TO SCALE  
FURNITURE NOT INCLUDED

For more information, please contact:

310.255.7777

leasing@douglasemmett.com

**Douglas  
Emmett**