
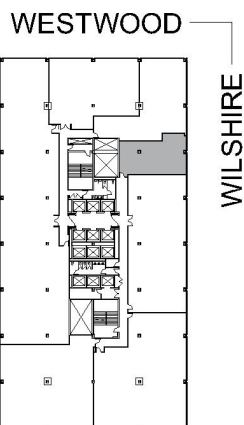


10880 WILSHIRE

SUITE 570 | 1,346 RSF

WESTWOOD

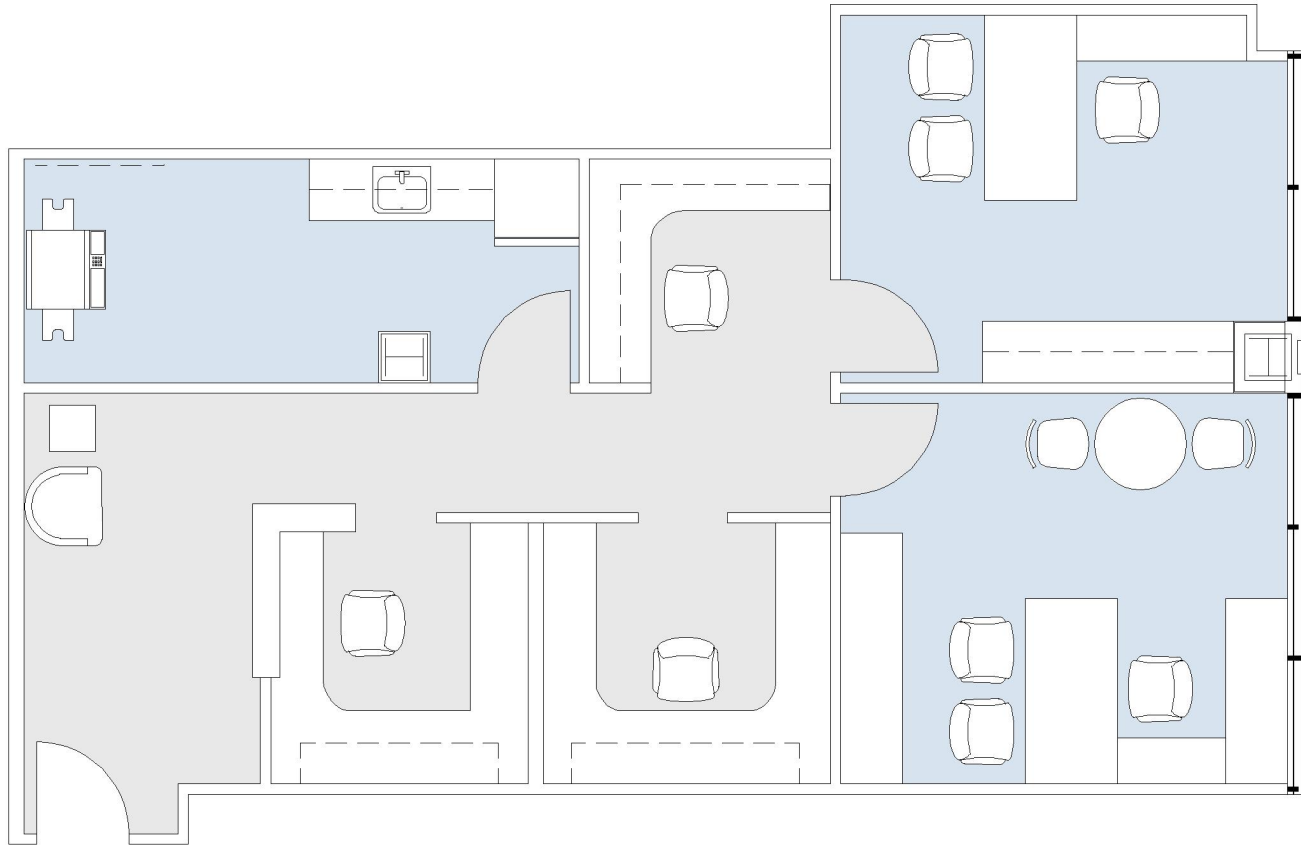

AS-BUILT CONFIGURATION

OFFICES:	2
RECEPTION:	1
KITCHEN:	1

NOT TO SCALE

FURNITURE NOT INCLUDED

For more information, please contact:

310.255.7777
leasing@douglasemmett.com

**Douglas
Emmett**